


# T.12S., R.3W., W.M.

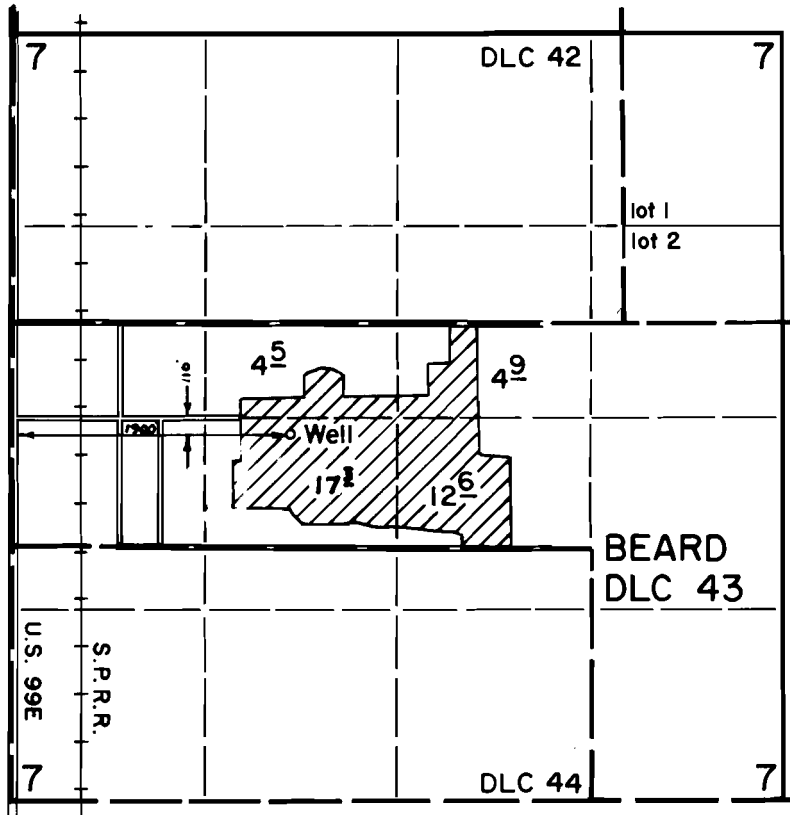

## FINAL PROOF SURVEY UNDER

Application No. G-5179 Permit No. G-5053  
IN NAME OF

STEVE & VIRGINIA GLASER

Surveyed April 13, 1976, by D. Norby