


T.I.S., R.I.E., W.M.

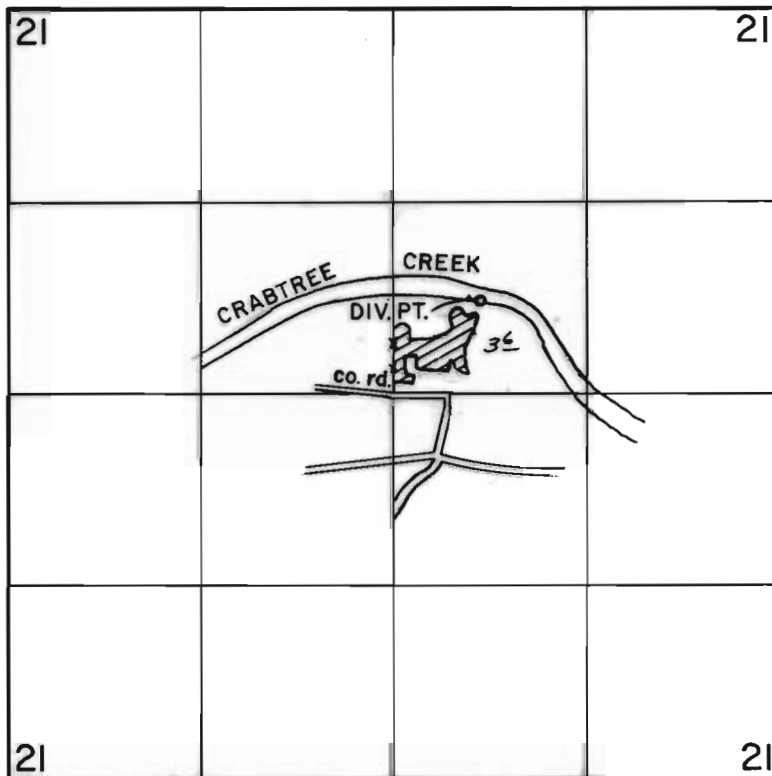

DIV. PT. LOC: 660' N & 600' E from center of sec. 21

FINAL PROOF SURVEY UNDER

Application No. 48625 Permit No. 36476
IN NAME OF

HIRAM H. & BONNIE F. HERN

Surveyed April 2 1976, by D. Norby