


# T.10S. R.2W. W.M.

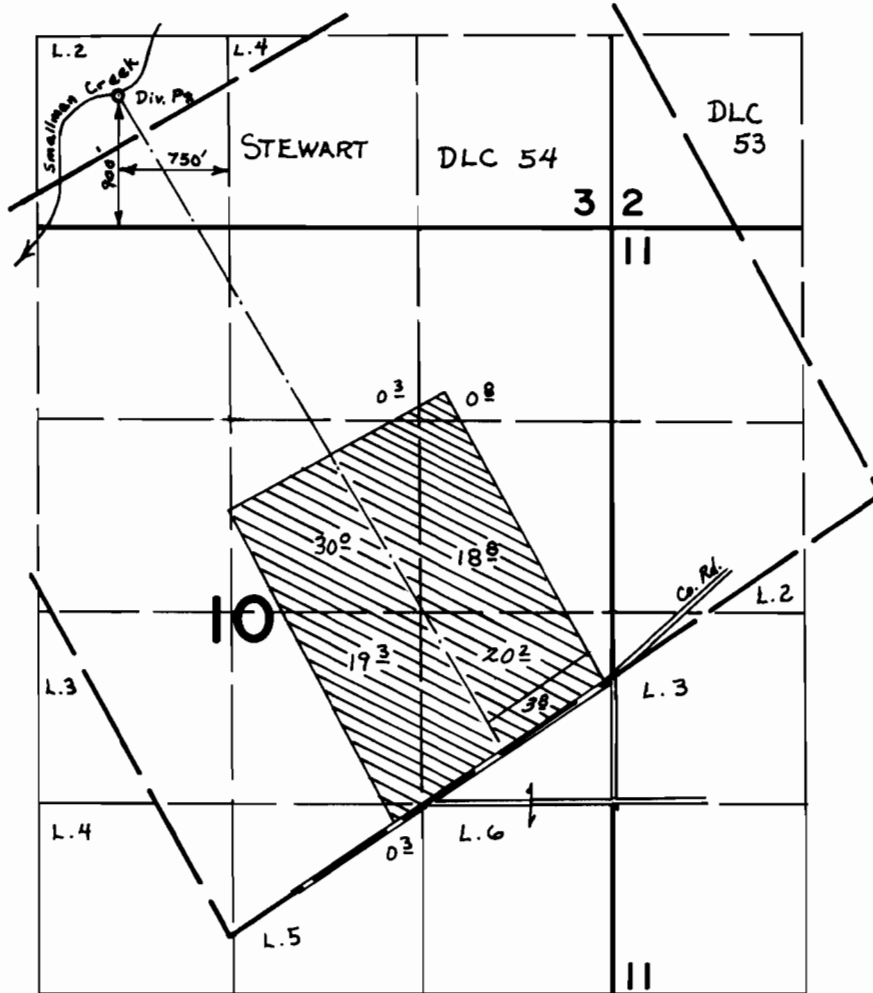

## FINAL PROOF SURVEY UNDER

Application No. 51567... Permit No. 38903.  
IN NAME OF

HARLAN & HELEN EASTMAN

Surveyed AUG. 11. 1977., by D. NORBY.....