


T.I.S.R. 2W.W.M.

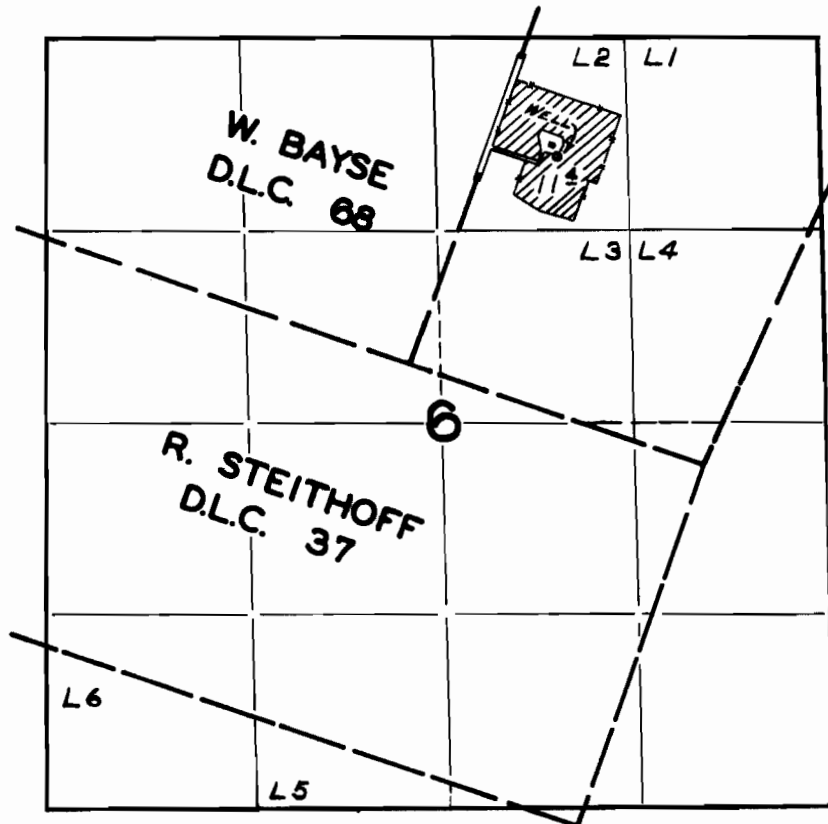

FINAL PROOF SURVEY

UNDER

Application No. G-492 Permit No. G-381

IN NAME OF

GEORGE C. & PAULINE SCHELER

Surveyed JULY 6 1961, by M BISH