




T.6S., R.3W., W.M.

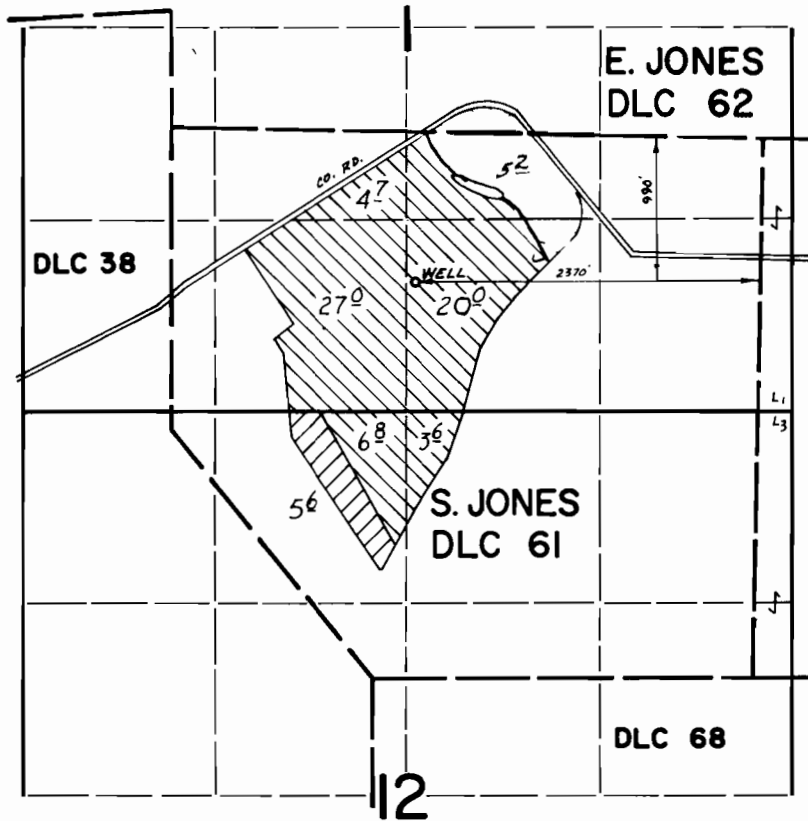

 - PRIMARY  
 - SUPPLEMENTAL

**FINAL PROOF SURVEY**  
UNDER

Application No. G-3847 Permit No. G-3623  
IN NAME OF

LENORA G. JONES

Surveyed Mar. 27 1975, by D. Norby