


T.6S.R.1E.W.M.

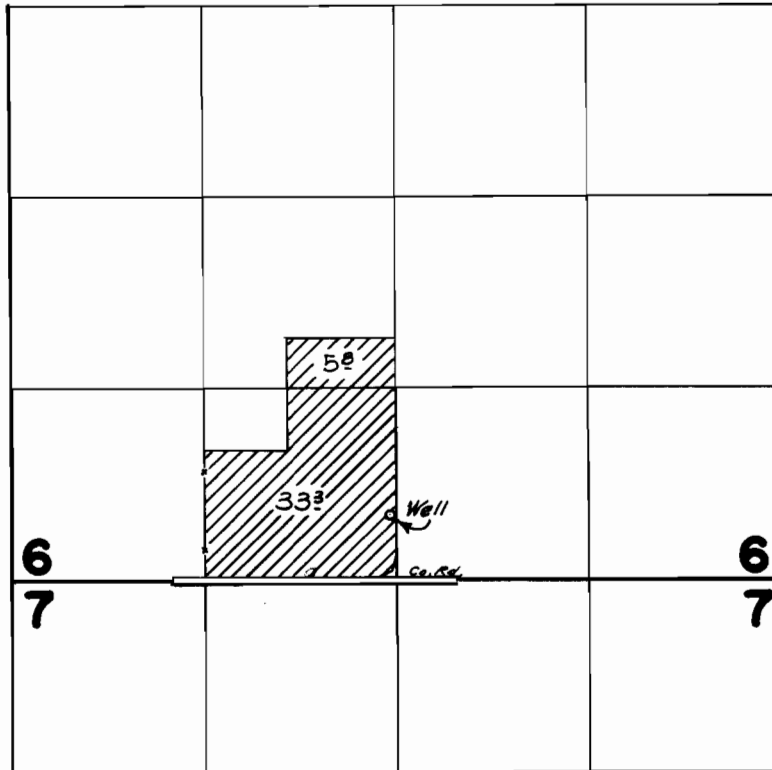

FINAL PROOF SURVEY UNDER

Application No. G-1339 Permit No. G-1267
IN NAME OF

.....CARL H. GOSCHIE.....

Surveyed May 3, 1963, by T. LAUER.....

Handwritten initials or signature.