


T.9S.,R.5W.,W.M.

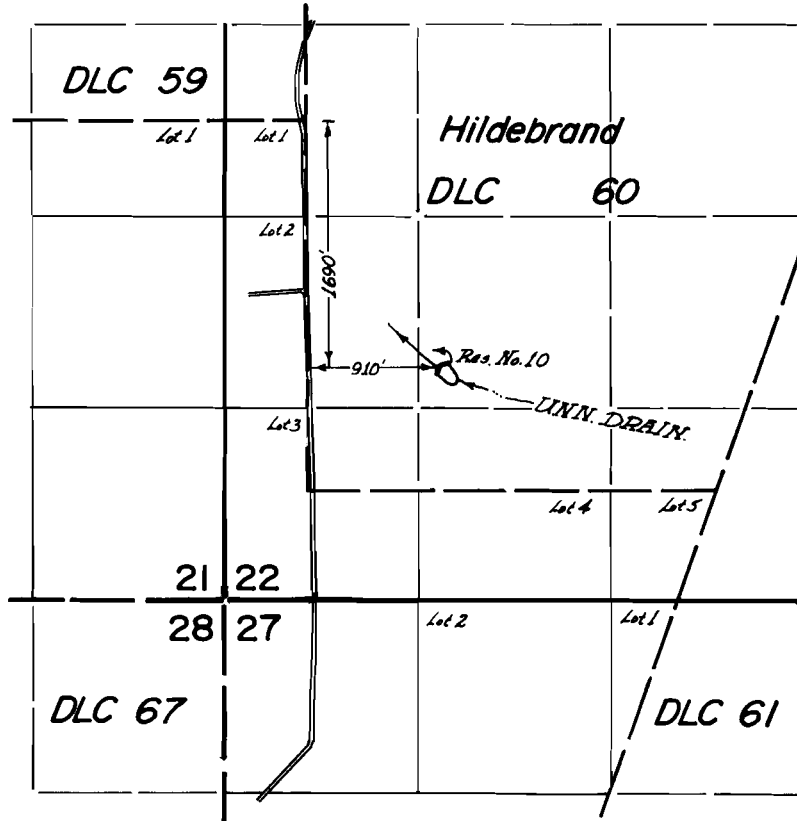

FINAL PROOF SURVEY
UNDER

Application No. R-48702. Permit No. R-5910...
IN NAME OF

..... NOBLE MTN. TREE FARMS

Surveyed *Oct. 13* 1978, by *S.P. Applegate*.....