


T. 9 S. R. 5 W. W. M.

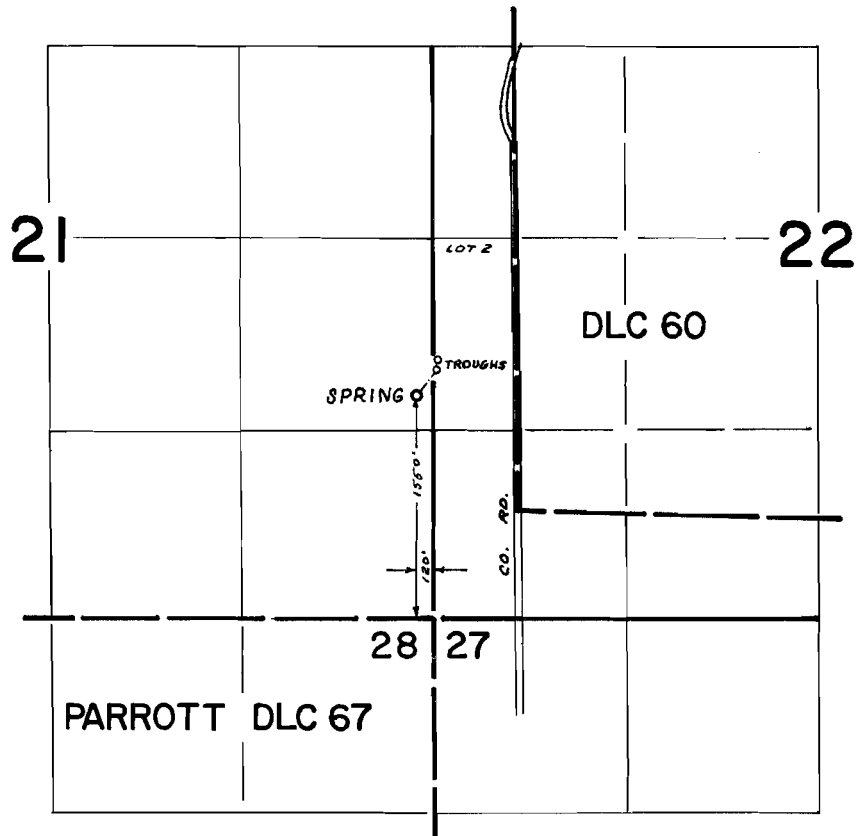

Application No. 53475 Permit No. 39783

IN NAME OF

ALVA W. & MARGERY A. MITCHELL

Surveyed December 9, 1970, by Donald R. Buell