


T-3296
3297

T.9S.R.5W. W.M.

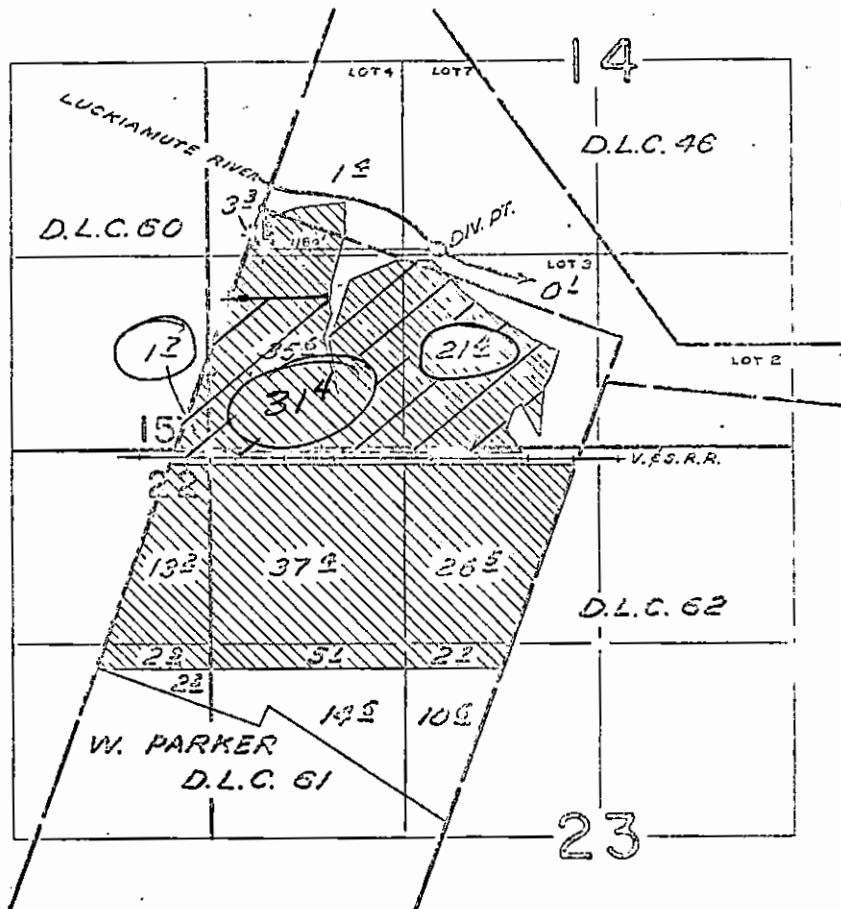

FINAL PROOF SURVEY UNDER

Application No. 37335 Permit No. 27812
IN NAME OF

Stephen Benedict

Surveyed Aug. 4, 1965, by C. GARDNER