


T.283S.R.47E.W.M.

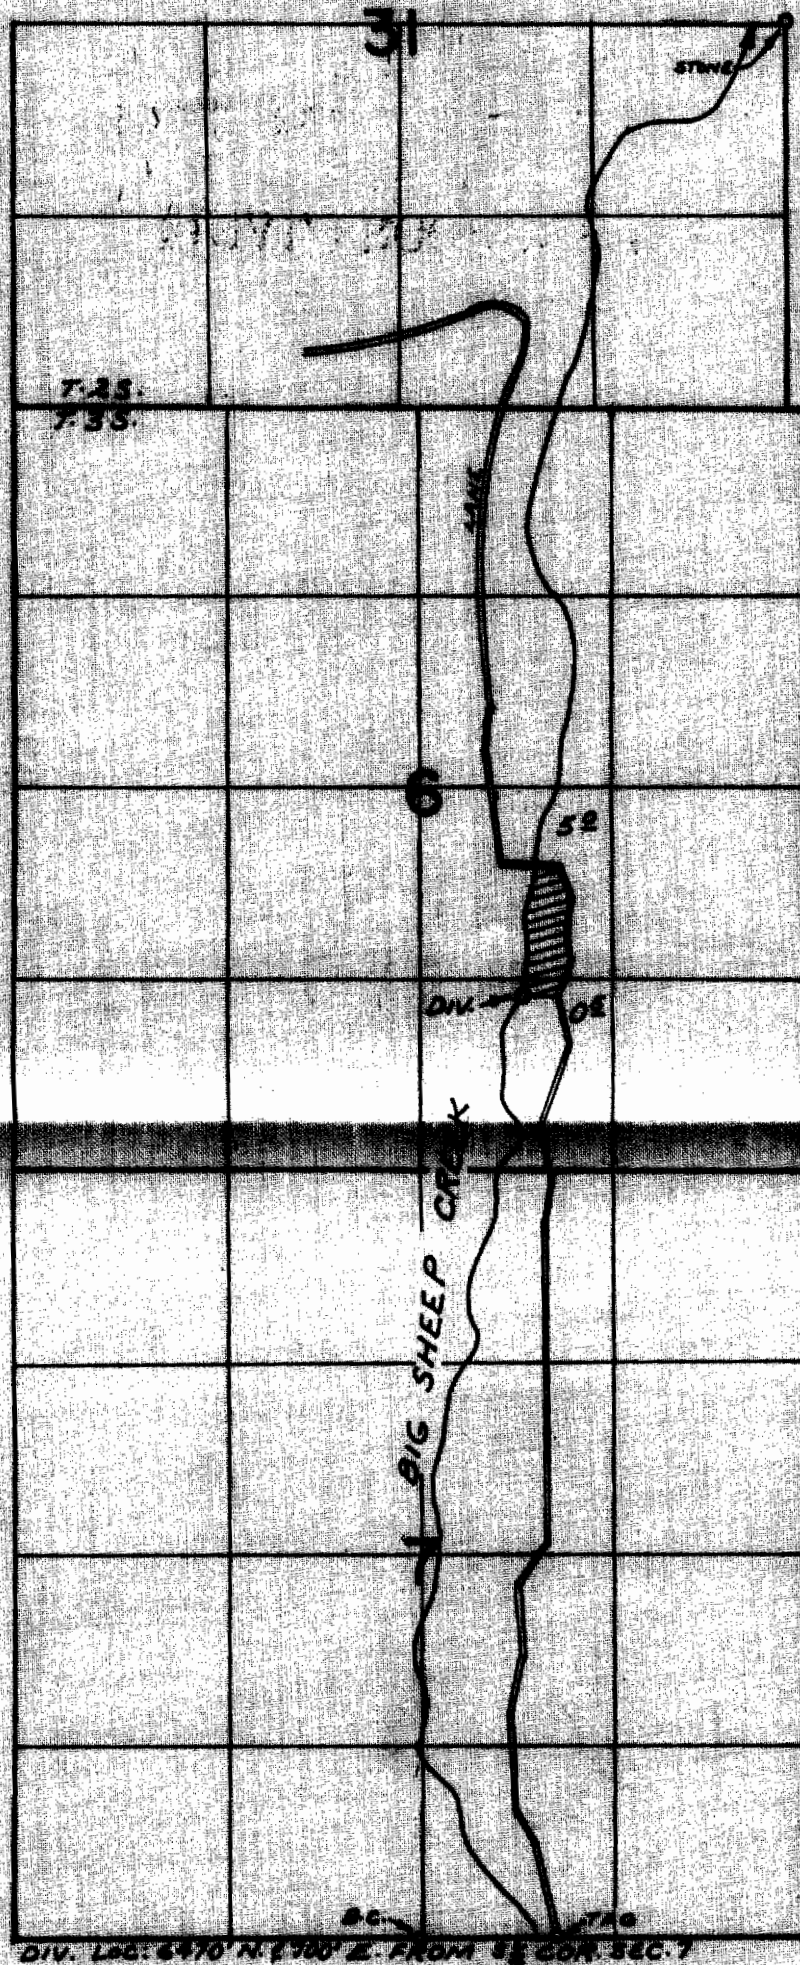

FINAL PROOF SURVEY

UNDER

Application No. 46787 Permit No. 34736

IN NAME OF

ESTATE OF FRED BIRD

Surveyed SEP 22 1976, by R. MUCKEN