


T.3S.R.43E.W.M.

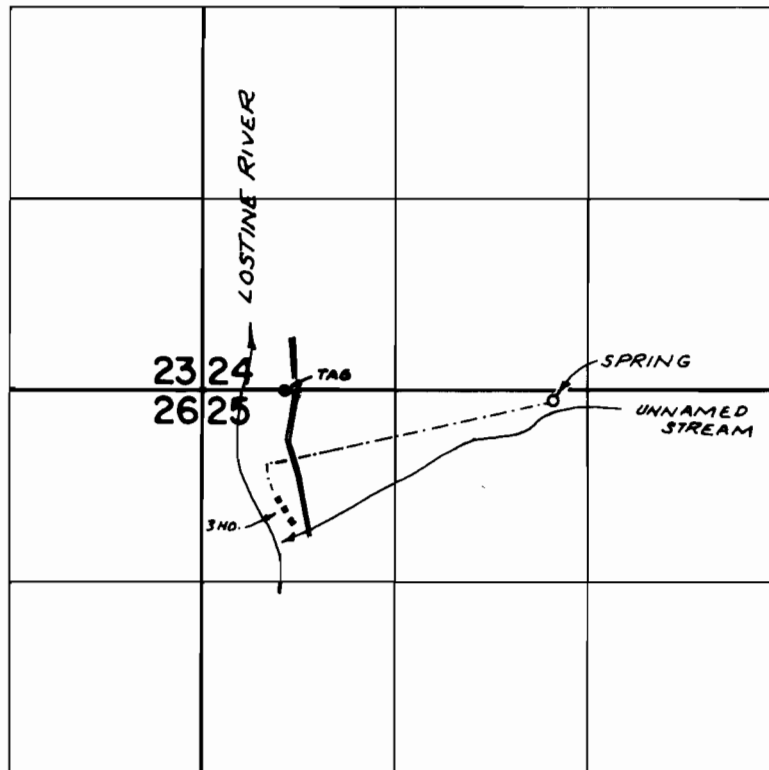

SPRING LOC. FROM APPL. MAP - 70'S. & 2400'E. FROM N.W. COR.
SEC. 25

FINAL PROOF SURVEY
UNDER

Application No. 48598 Permit No. 36802
IN NAME OF

MILDRED D. READ

Surveyed SEPT. 29, 1976, by R. MUCKEN