


BY _____ DATE _____
CHKD. BY _____ DATE _____

SUBJECT CITY OF DUFUR, OREGON
Map to accompany application for
permit to appropriate groundwater

SHEET NO. _____ OF _____
JOB NO. _____

G-3409

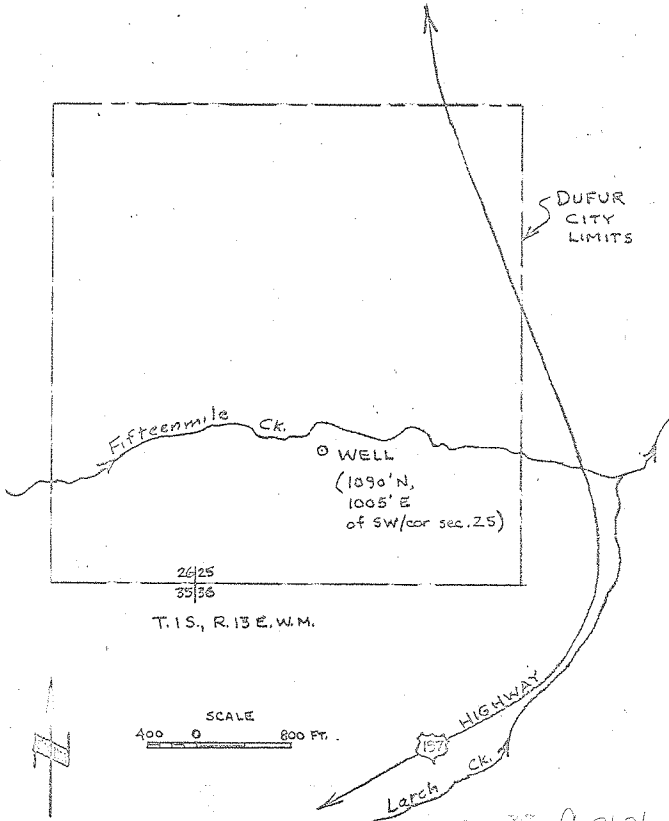

Application No. G-3626
Permit No. G-3409