


37300

NORTH

-----1320'-----

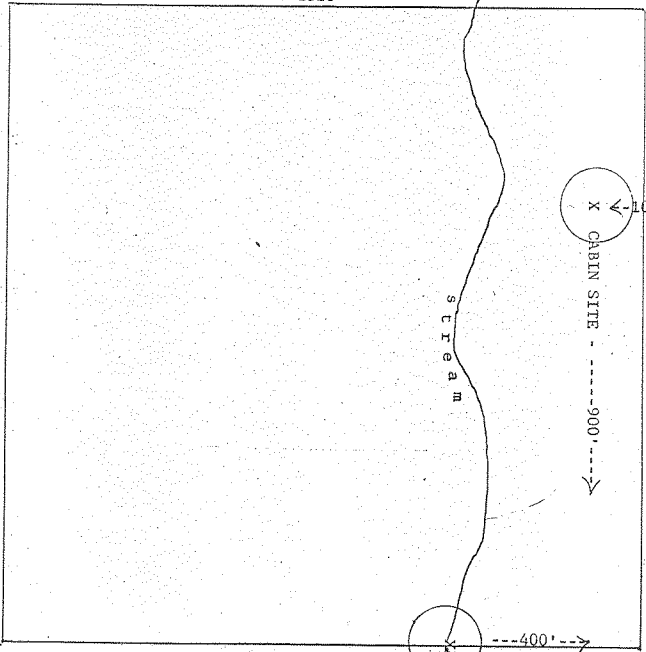

EAST

s
t
r
e
a
m

X
CABIN SITE

←100'←

-----900'-----



-----1320'-----

-----400'-----



Point of diversion

SOUTH

1" = 100'

Approx. scale: 1/2" = 100'

NW 1/4 of SW 1/4 of Section 12
Wasco County, Oregon

RECEIVED

MAR 13 1974

STATE ENGINEER
SALEM, OREGON

Application No. 51745

Permit No. 37300