
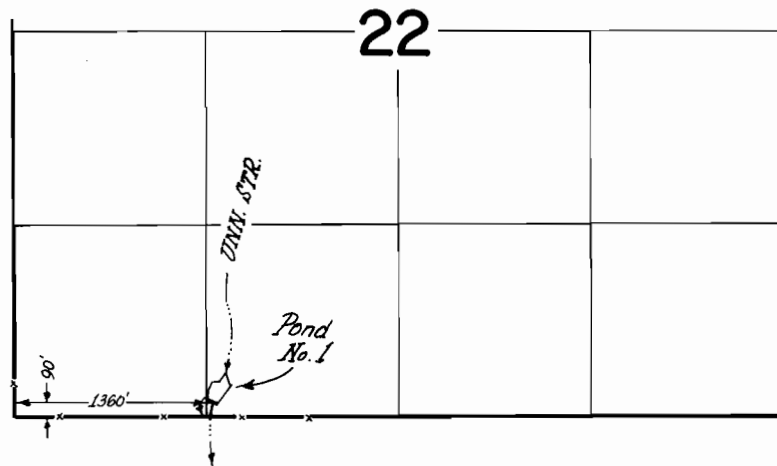


T.8S.,R.17E.,W.M.

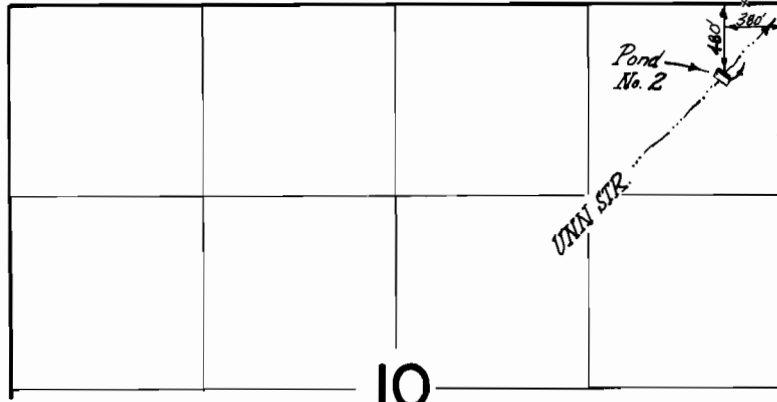

**FINAL PROOF SURVEY**  
UNDER

Application No. R-52454 Permit No. R-6309  
IN NAME OF

W. L. DICKSON

Surveyed Aug. 31 1977, by P.G. Mucken