


T.2S.R.2W.W.M.

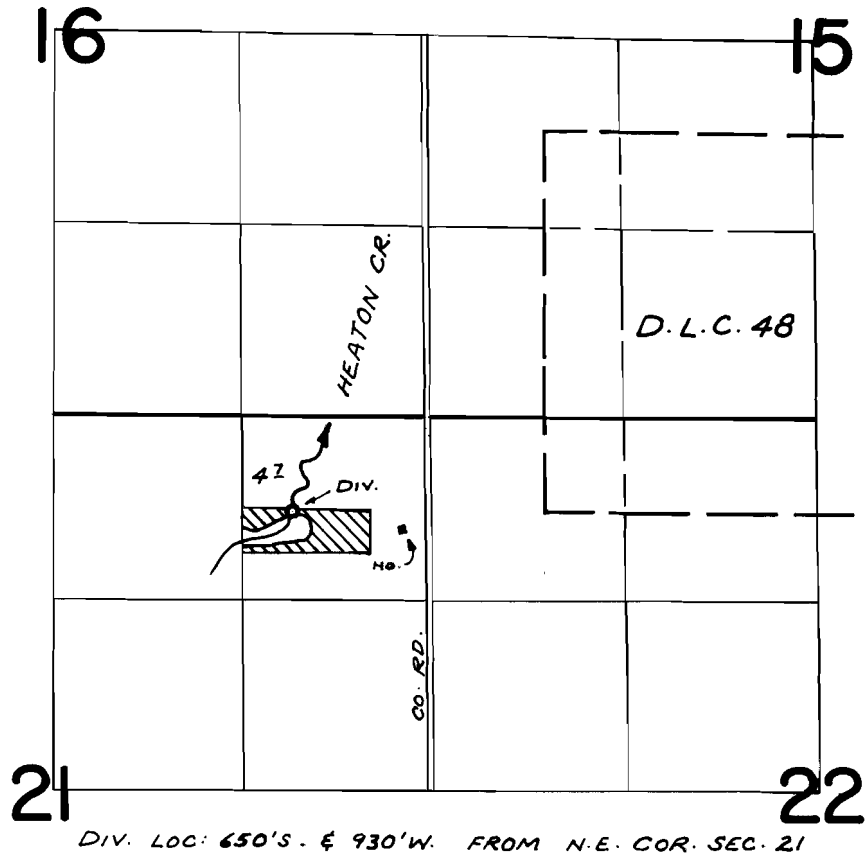

FINAL PROOF SURVEY
UNDER

Application No. 43958 Permit No. 32840
IN NAME OF

BRUCE DODGE

Surveyed SEPT. 27, 1977, by R. MUCKEN