


T.2S.R.3W.W.M.

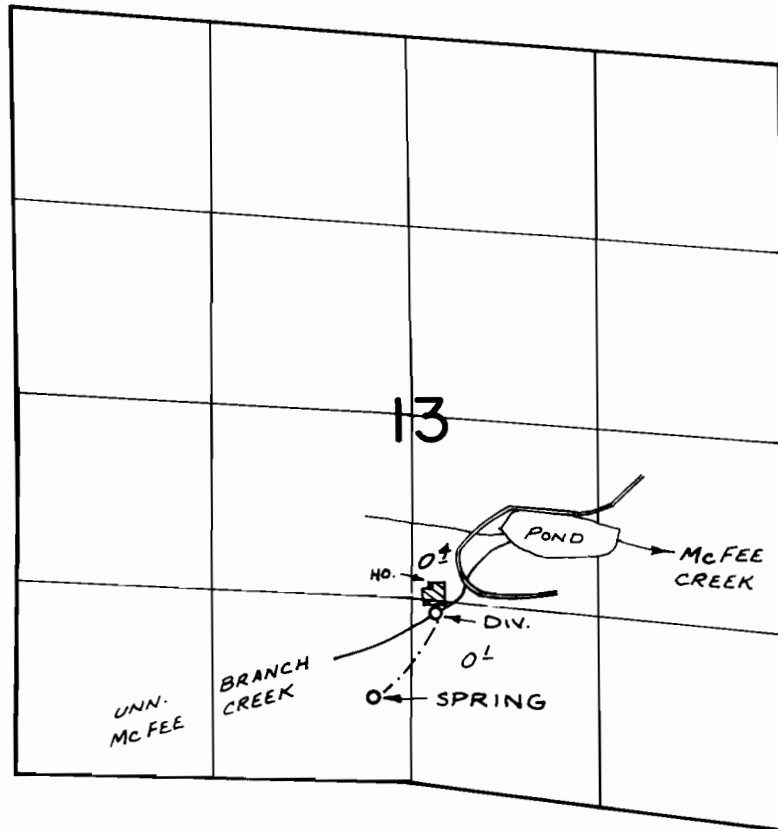

DIV. LOC: 1170'N. & 170'E ; SPRING LOC: 580'N. & 250'W,
BOTH FROM S $\frac{1}{2}$ COR. SEC. 13

FINAL PROOF SURVEY
UNDER

Application No. 49634 Permit No. 37204
IN NAME OF

MAMIE PHILLIPS

Surveyed SEPT. 10, 1976, by R. MUCKEN