


T.I.S.R.4W.W.M.

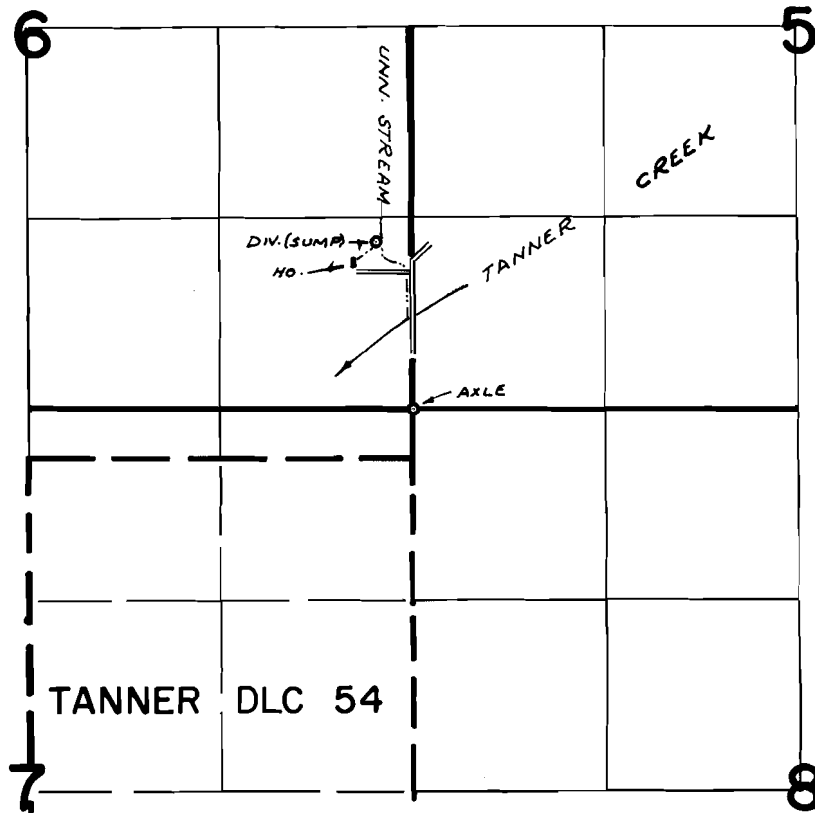

DIV. LOC: 1140' N. & 240' W. FROM S.E. COR. SEC. 6

FINAL PROOF SURVEY UNDER

Application No. 50116 Permit No. 37846
IN NAME OF

ROLLO L. KINTZ

Surveyed NOV. 7, 1977, by R. MUCKEN