


T.3N.R.3W., W.M.

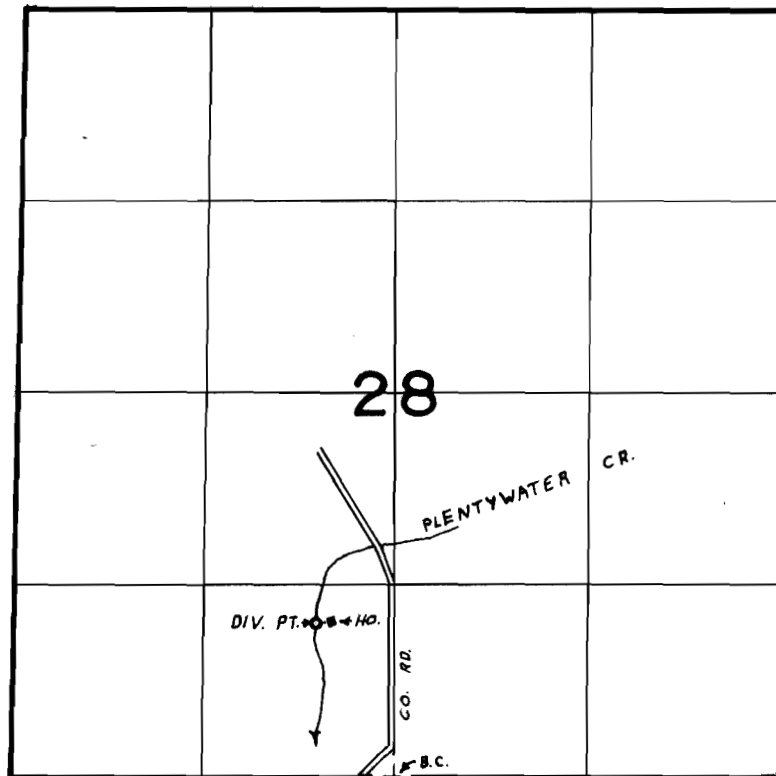

DIV. PT. LOC. 1060' N. & 540' W. FROM S. 1/4 COR. SEC. 28

FINAL PROOF SURVEY
UNDER

Application No. 53723 Permit No. 40346
IN NAME OF

GARY A. LAHAIE

Surveyed NOV. 10, 1977, by R. G. MUCKEN