


T.2S. R.1W., W.M.

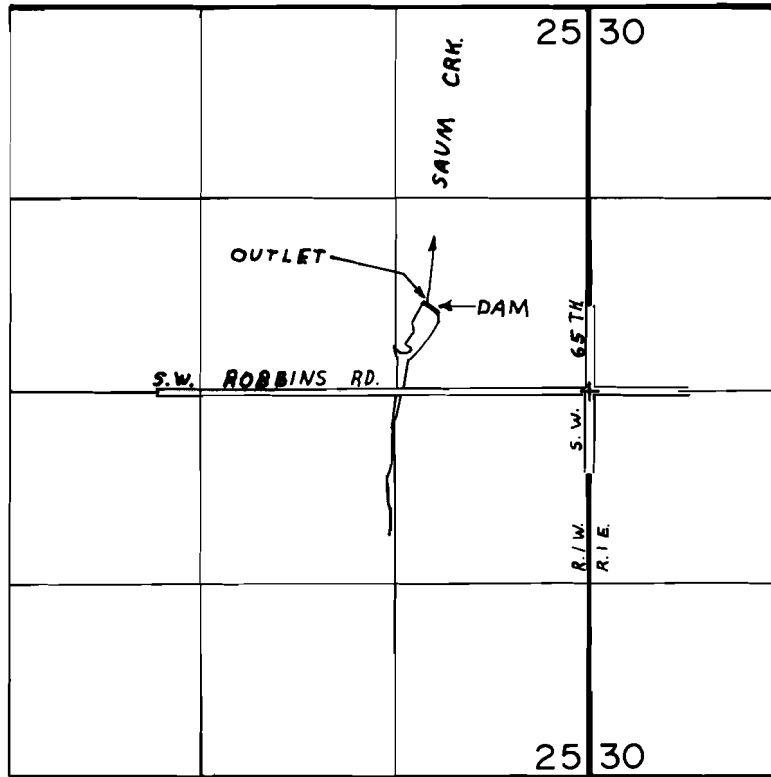

OUTLET LOC. 600' N. & 1120' W. FROM E. 1/4 COR. SEC. 25

FINAL PROOF SURVEY UNDER

R-54188 R-6508
Application No. 54685 Permit No. 40830
IN NAME OF

CARL P. & NINA B. HANSEN

Surveyed JUL 8, 1977, by R. G. MUCKEN