


P- 32824
47557

T.7S.,R.19E.,W.M.

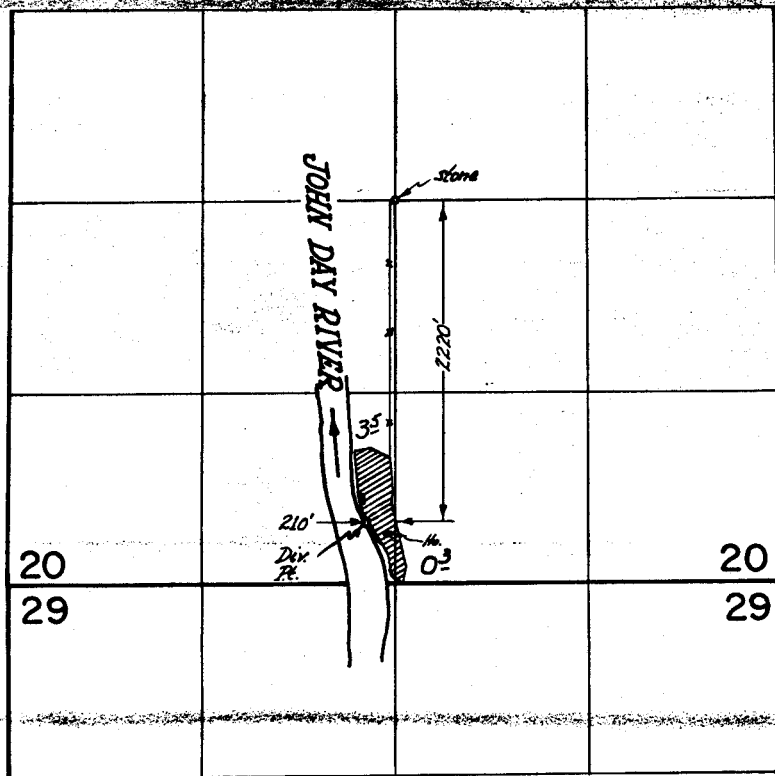

FINAL PROOF SURVEY
UNDER

Application No. 43920. Permit No. 32824. - C-47557
IN NAME OF

LEROY & RUTH FREEDLE.....

Surveyed Aug. 26... 1977., by R.G. Mucken.....