


P-41018
47559

T.8S.,R.24E.,W.M.

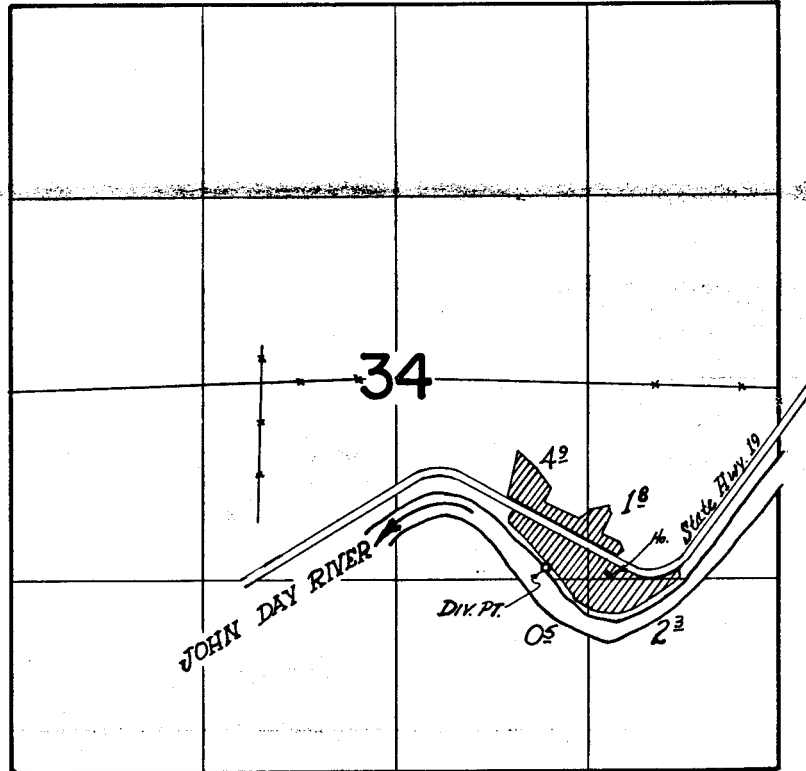

DIV. PT. LOC.: 1240' S & 1620' W. FROM EAST 1/4 COR. SEC. 34.

FINAL PROOF SURVEY
UNDER

Application No. 54669 Permit No. 41018
IN NAME OF

ROBERT O. GRIGGS

Surveyed Aug. 27 1977, by R. G. Mucken

1977-Z AR