


T. 6 S. R. 4 W. W. M.

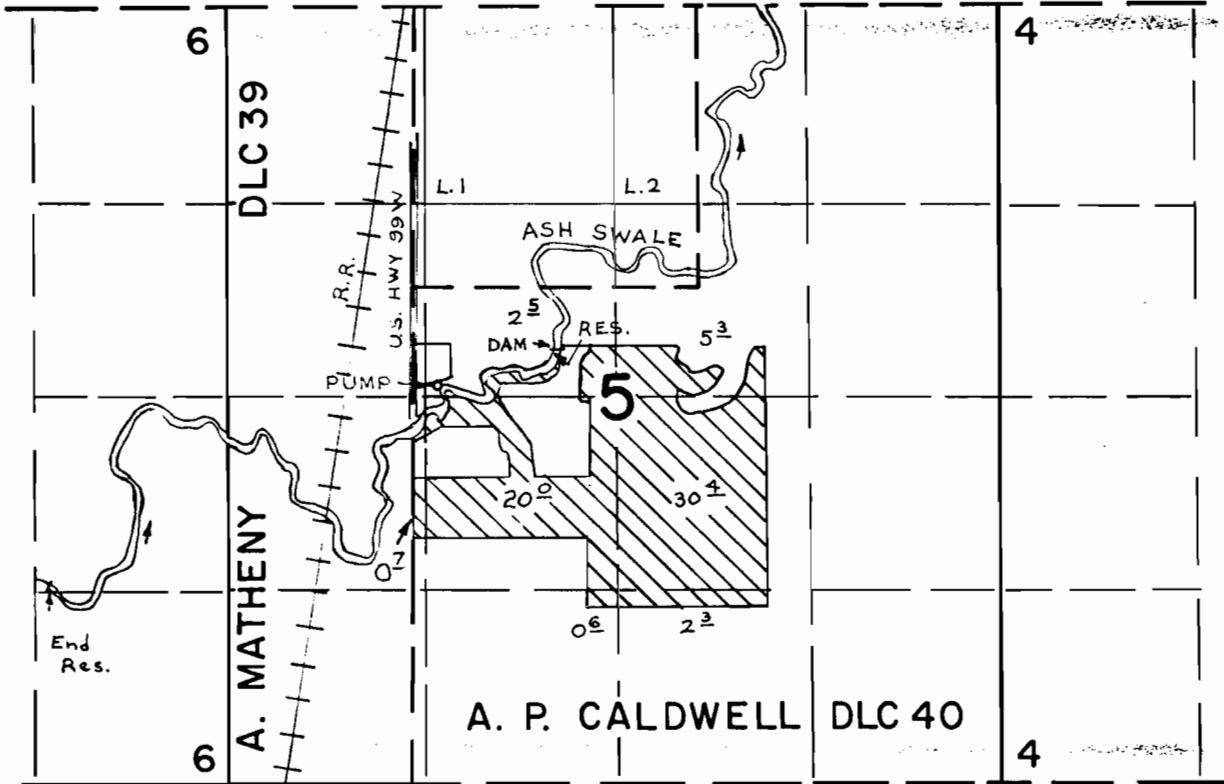

PUMP LOC. - 70' N. & 1220' W. FROM CENTER SEC. 5
 DAM LOC. - 310' N. & 400' W. FROM CENTER SEC. 5

FINAL PROOF SURVEY UNDER

R-46305 R-5510
 Application No. 46306 Permit No. 34585
 IN NAME OF
ARNOLD J. KRAITZ

Surveyed April 30 1976, by R.G. Mucken.