


# T4S R3W WM

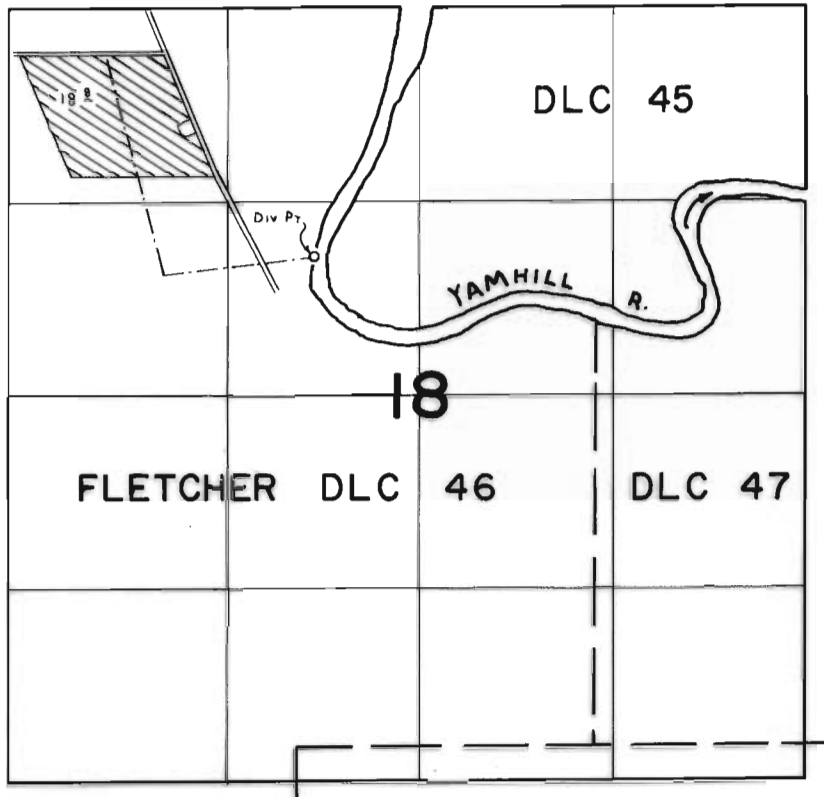

Div Pt Loc: 960' N & 720' W fr. Ctr. 1/4 Sec. 18.

## FINAL PROOF SURVEY UNDER

Application No. 50848 Permit No. 38392  
IN NAME OF

THOMAS R. ROTH

Surveyed JUNE 3 1976, by L. H. NUNN.