


T.6S.R.6W.W.M.

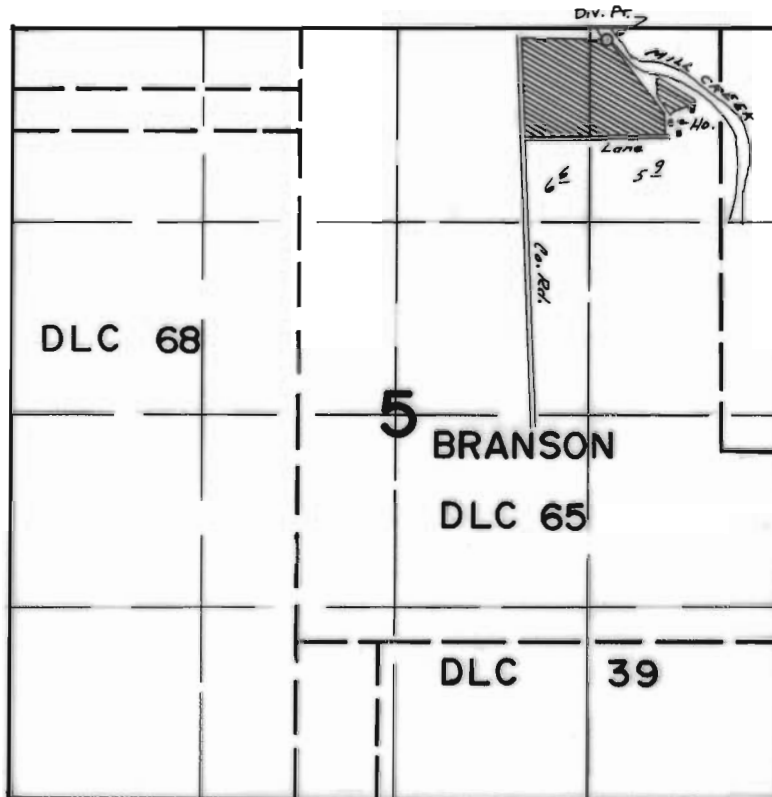

Div. Pt. 110' S & 1200' W From NW Cor. Sec. 5

FINAL PROOF SURVEY UNDER

Application No. 50925. Permit No. 38448.
IN NAME OF

ZARA R. POTTER

Surveyed July 20 1977, by S.C. BROWN