


T. 5S., R. 5W., W.M.

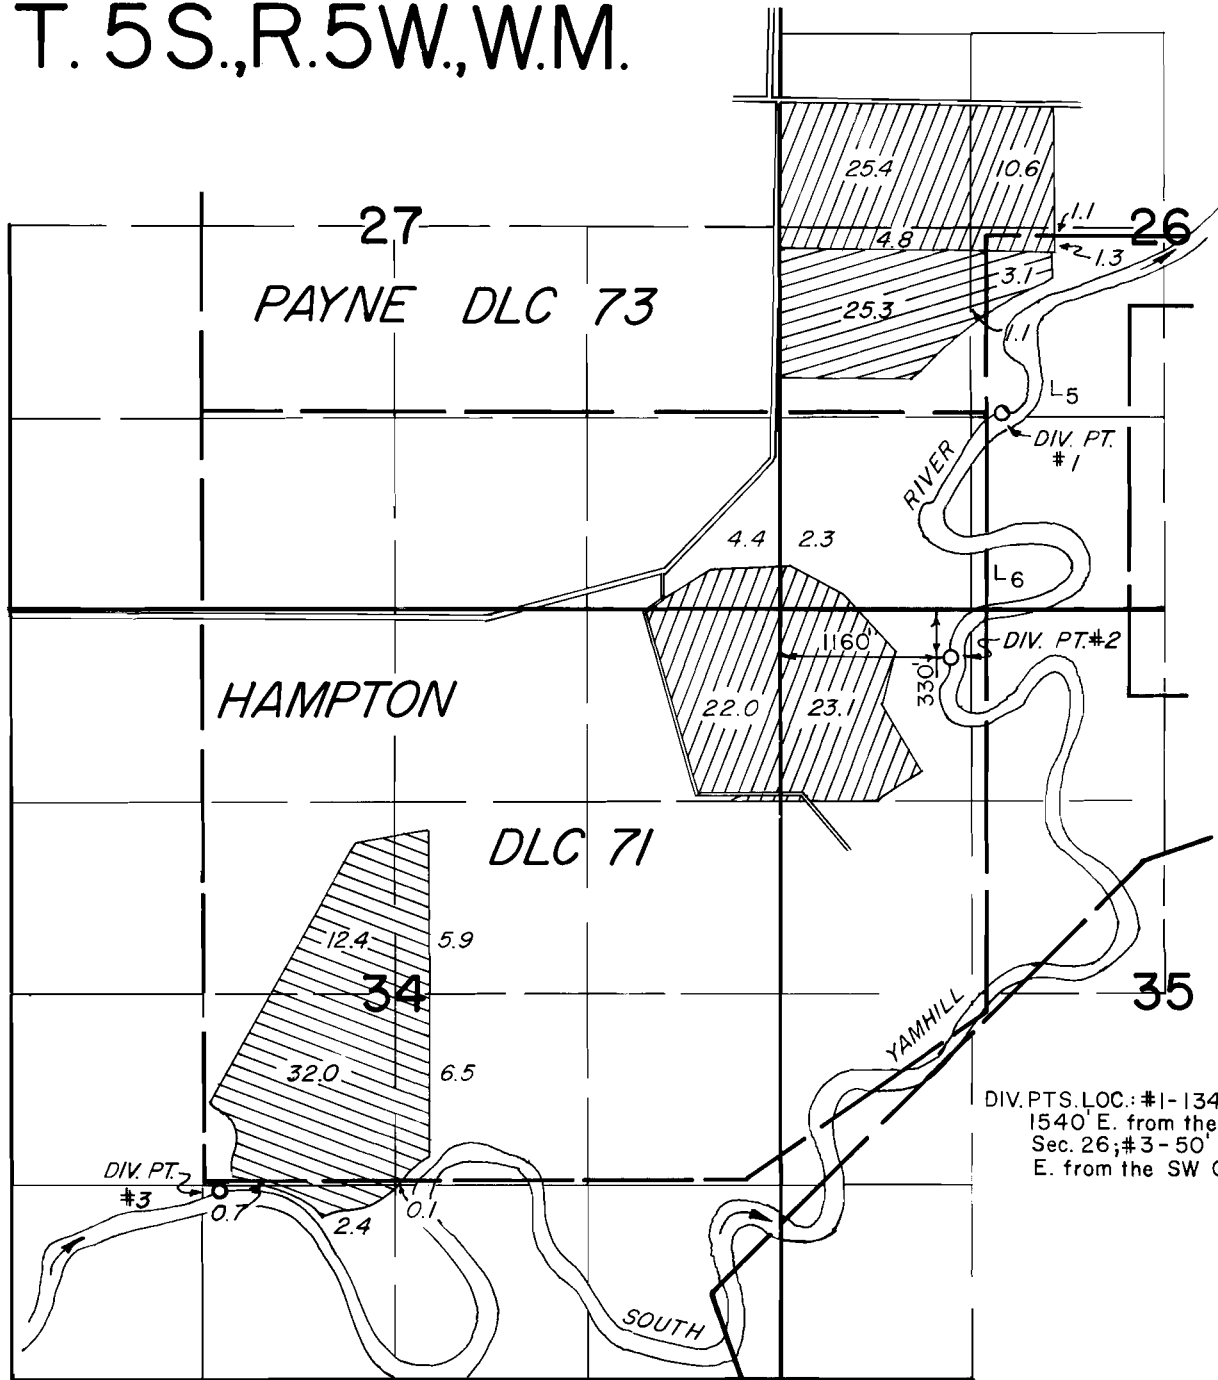

UNDER

Application No. 54471 54472 55832 Permit No. 40859 40860 42508

IN NAME OF

**CRIMSON WEST FARMS**

Surveyed JULY 20, 1977, by *J. Brown*  
MAY 31, 1979

