


T.14S. R.8W.W.M.

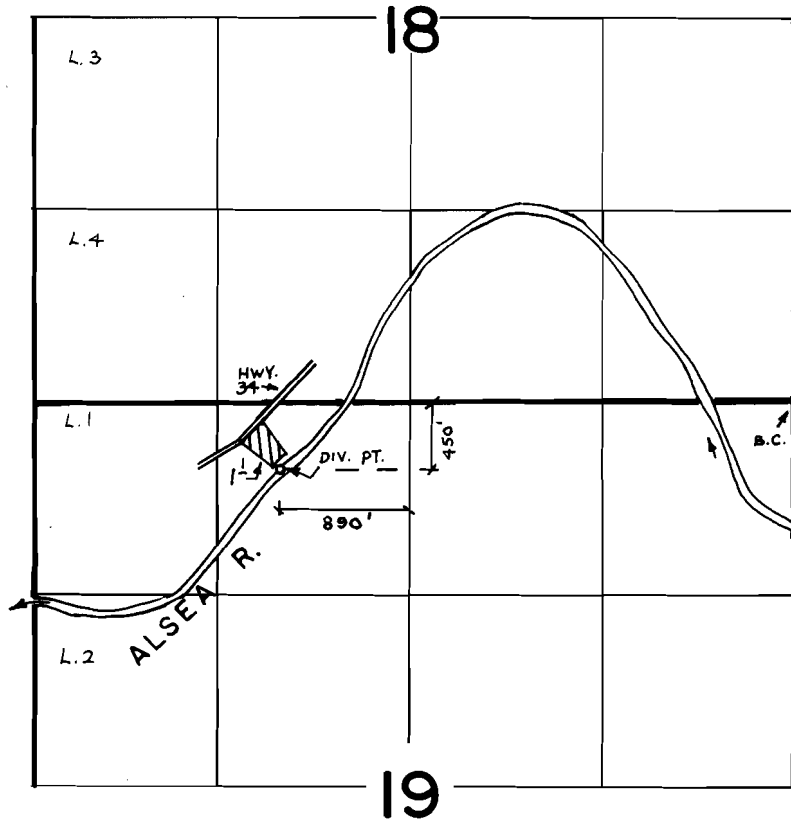

FINAL PROOF SURVEY UNDER

Application No. 50616 Permit No. 38250
IN NAME OF

HOWARD M. LEE

Surveyed April 29 1977, by L.M. Toll