


T.14 S., R.8 W., W.M.

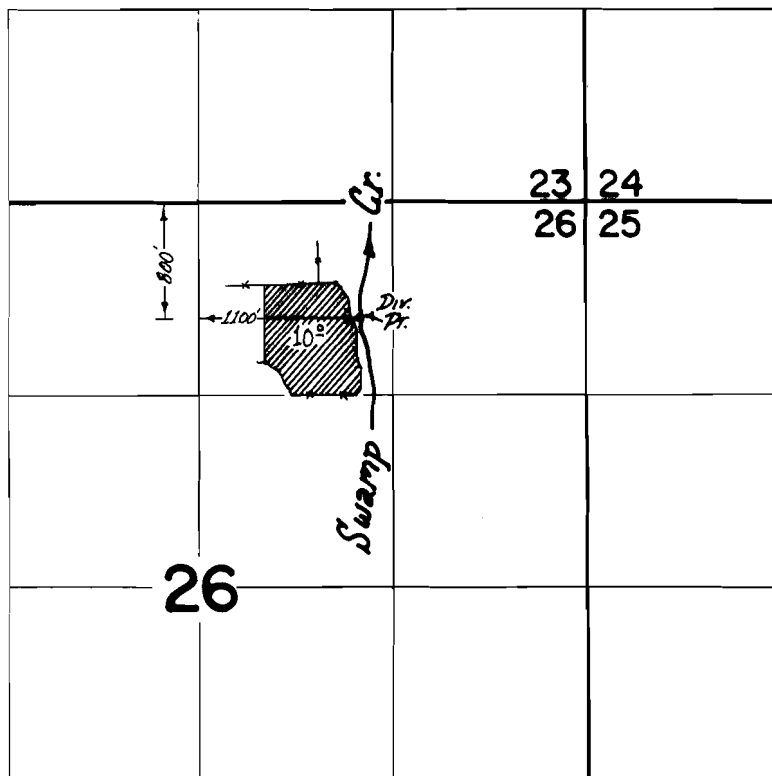

FINAL PROOF SURVEY
UNDER

Application No. 53728 Permit No. 40350
IN NAME OF

DONALD I. PODMORE

Surveyed April 29 1977, by L.M. TOLL