


RECEIVED

DEC 6 1973
STATE ENGINEER
SALEM, OREGON

T.2S.R.4E.W.M.

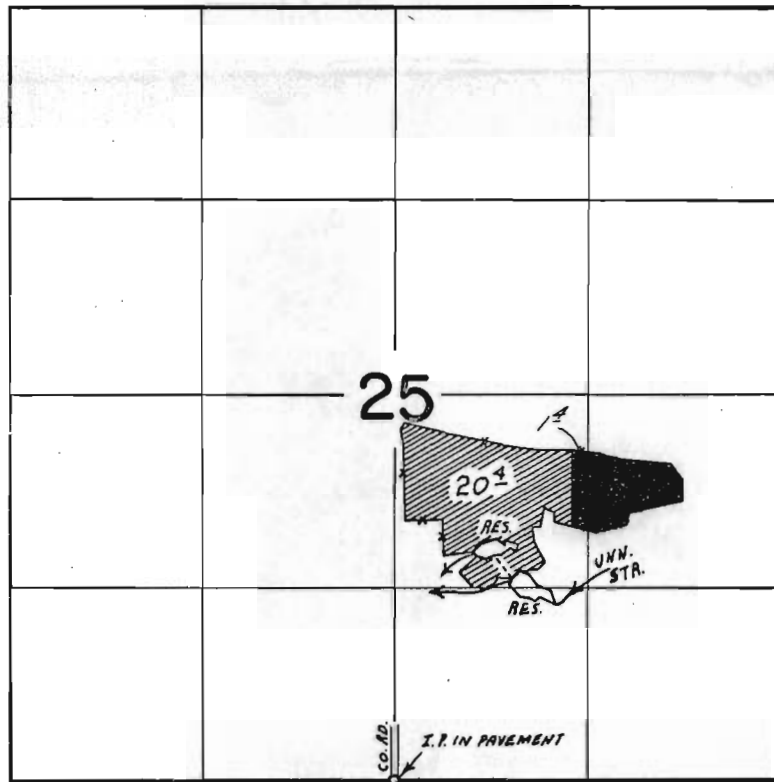

DIV. PT. LOC. 1350' N. & 790' E. FROM S $\frac{1}{4}$ COR. SEC. 25 (ALSO S. RES. DIV. PT.); N. RES. DIV. PT. LOC. 1540' N. & 540' E. FROM S $\frac{1}{4}$ COR. SEC. 25

☐ New application

approved by: Dale C. Quinn
FINAL PROOF SURVEY

UNDER

38985 29044
Application No. R-40949 Permit No. R-4588
40950 30509
IN NAME OF

DALE C. QUINN

Surveyed NOV. 13 1970, by G. BACA

Application No. 51530

Permit No. 38884