


# T.2S.R.1E.W.M.

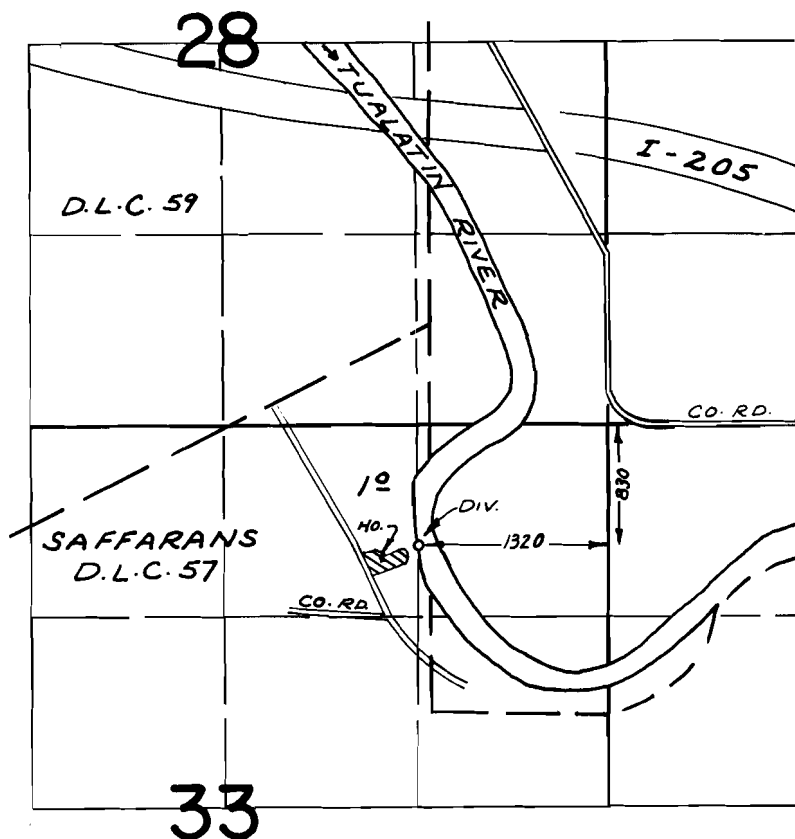

## FINAL PROOF SURVEY UNDER

Application No. ~~53464~~ Permit No. 39776...  
IN NAME OF

.....ARTHUR J. HOWSER.....

Surveyed July 6, 1977, by R. MUCKEN