


# T.5S.,R.1E.,W.M.

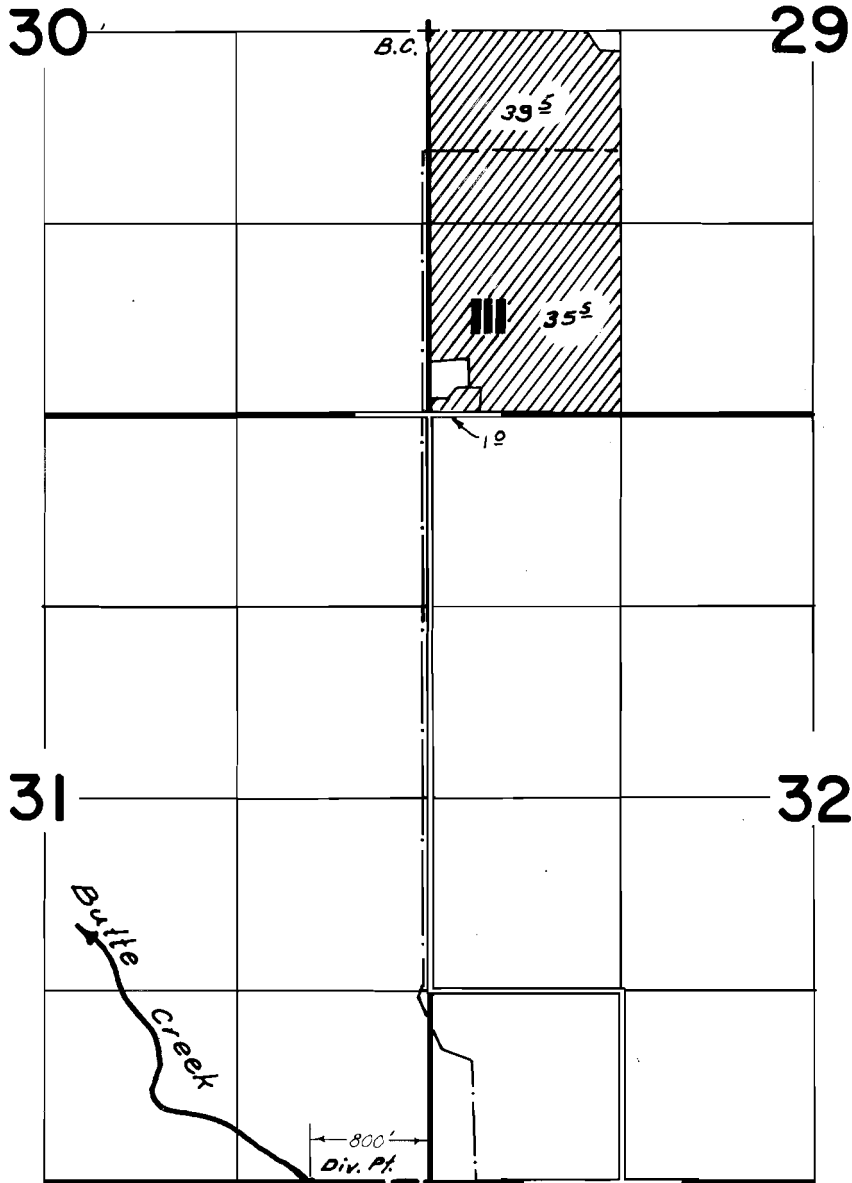

## FINAL PROOF SURVEY UNDER

Application No. 53489 Permit No. 39791  
IN NAME OF

Robert A. Anderson

Surveyed July 26, 1977, by A.C. Brown