


T. 2 S. R. 5 E. W. M.

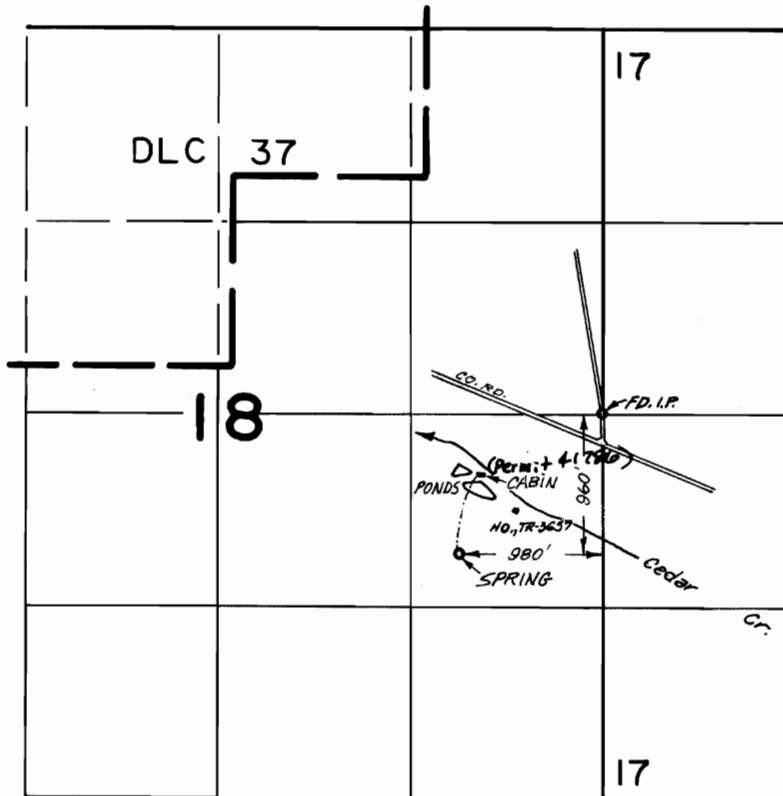

FINAL PROOF SURVEY
UNDER

Transfer No. 3657

55814

41786

Application No. 47199 Permit No. 34784

IN NAME OF

SIDNEY BREWSTER

MAR. 24, 1978

Surveyed SEPT. 23, 1975, by R.G. MUCKEN