


T.4S. R.1E. W.M.

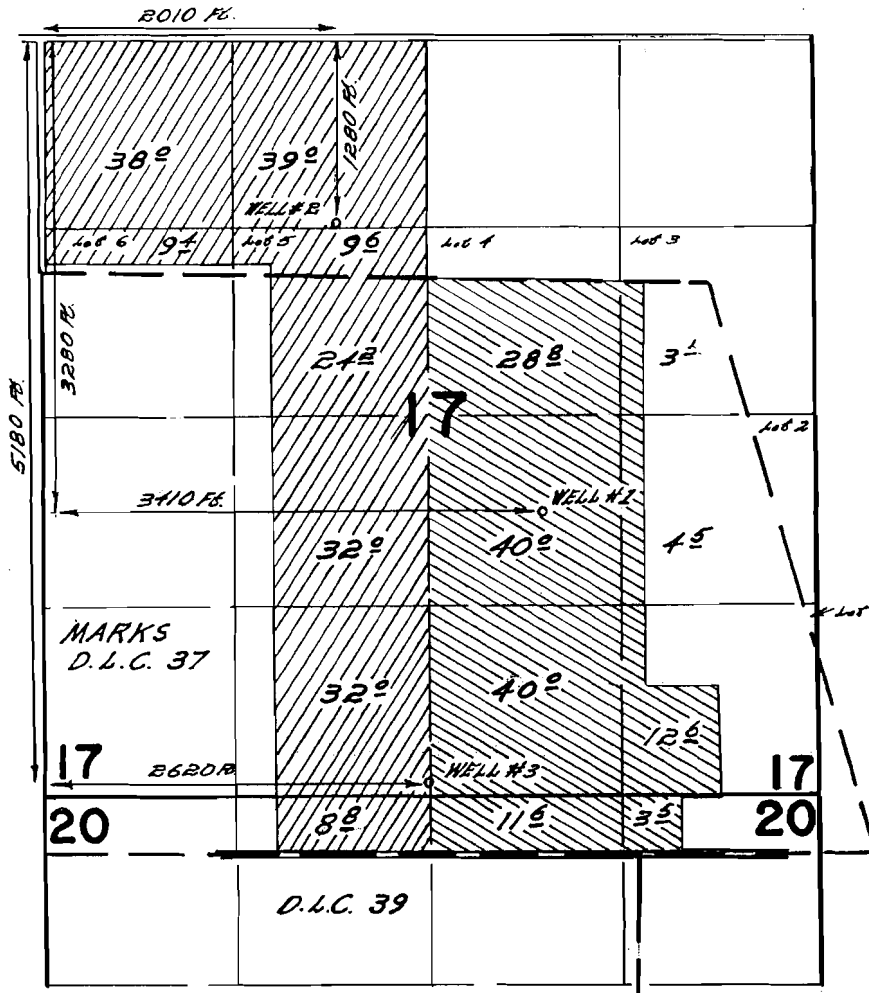

G-2921 PRIMARY WELLS #1,2,6,3
 G-2864 PRIMARY WELL #1
 G-2921 SUPPL. WELLS #2,3

Well 1: CLAC 13297 }
 CLAC 13299 }
 Well 2: CLAC 13296 }
 Well 3: CLAC 13297 }
 13299 }


FINAL PROOF SURVEY

Revised UNDER
 Per Donn Miller (see T-7042 } KCLW
 Also agrees w/ order drilled. }

Application No. G-3077 Permit No. G-2864
 G-3223 G-2921
 IN NAME OF

OECO CORPORATION
AGRICULTURAL SCIENCES, INC.
 Surveyed July 3, 1968, by W.D. Ruppert

T.4S. R.IE. W.M.

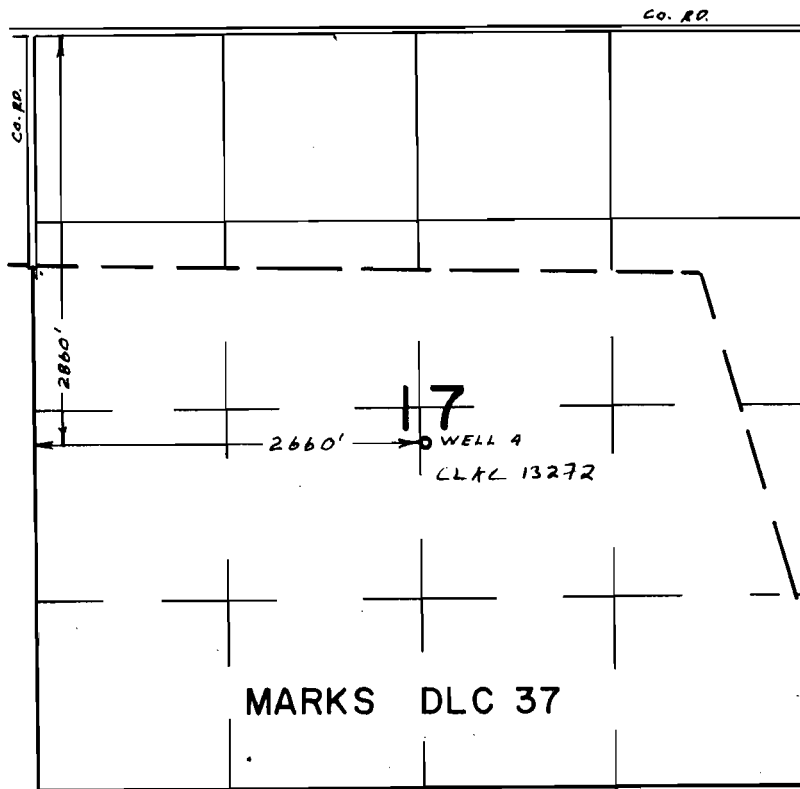

FINAL PROOF SURVEY UNDER

TRANSFER 3427
Application No. Permit No.
IN NAME OF

J. FRANK SCHMIDT & SON CO.

Surveyed NOV. 10. 1977, by L.H. NUNN