


T.7N.R.5W.W.M.

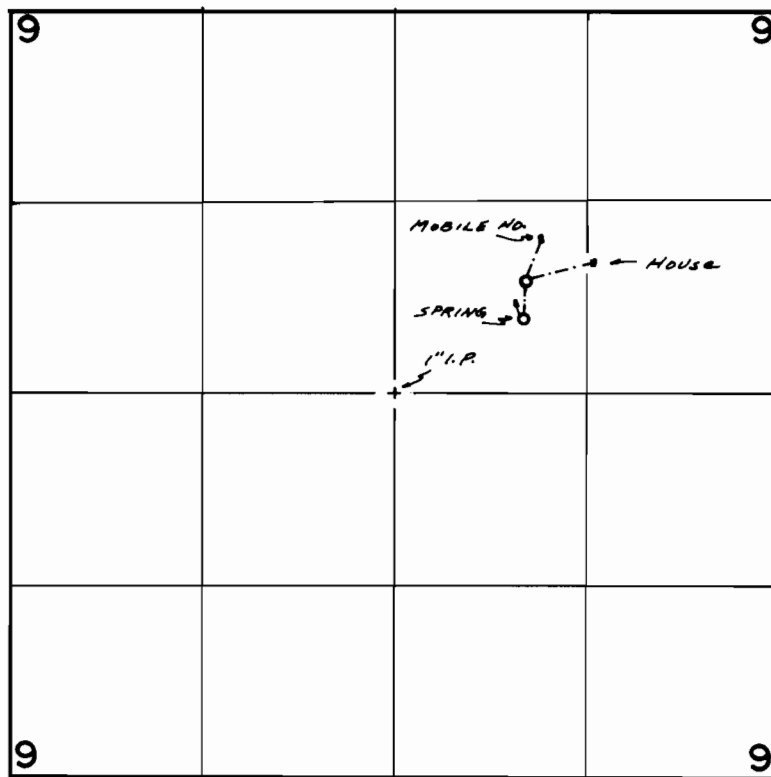

SPRING LOC. - 500' N of 900' E From Center 1/4 Cor. Sec. 9

**FINAL PROOF SURVEY**  
UNDER

Application No. 41894..... Permit No. 31253..  
IN NAME OF

.....KEN RICHARDS.....

Surveyed Aug. 26 1977, by S.C.BROWN.....