


T. 5 N. R. 2 W. W. M.

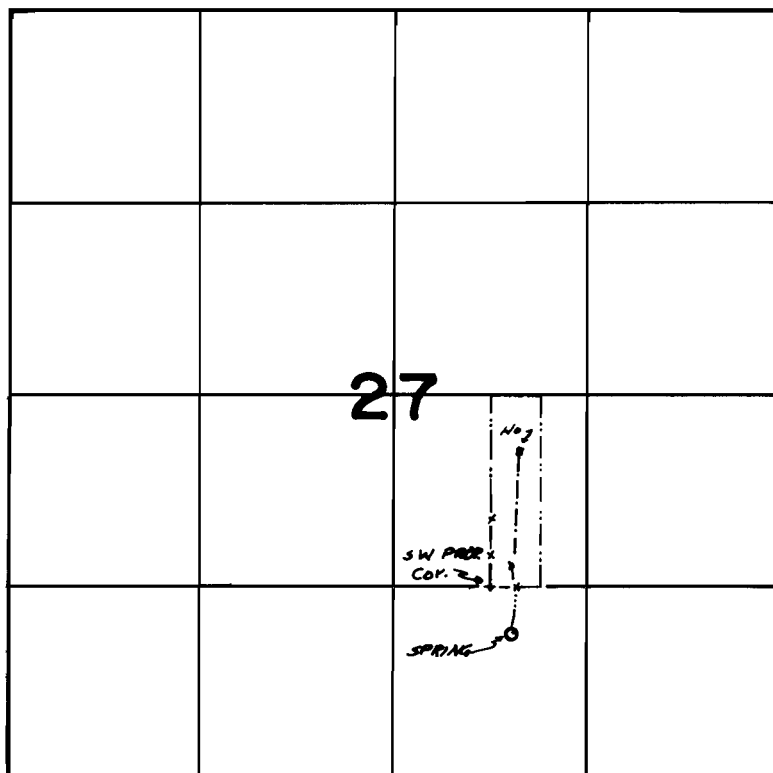

SPRING LOC. - 1620' S; 800' E FROM NW COR., SE 1/4 SEC 27

FINAL PROOF SURVEY
UNDER

Application No. 49790. Permit No. 37458.
IN NAME OF

FRANK OTT III & MARGARET K. OTT

Surveyed 8-16-1977, by S.C. BROWN