


# T.24S. R.IIW, W.M.

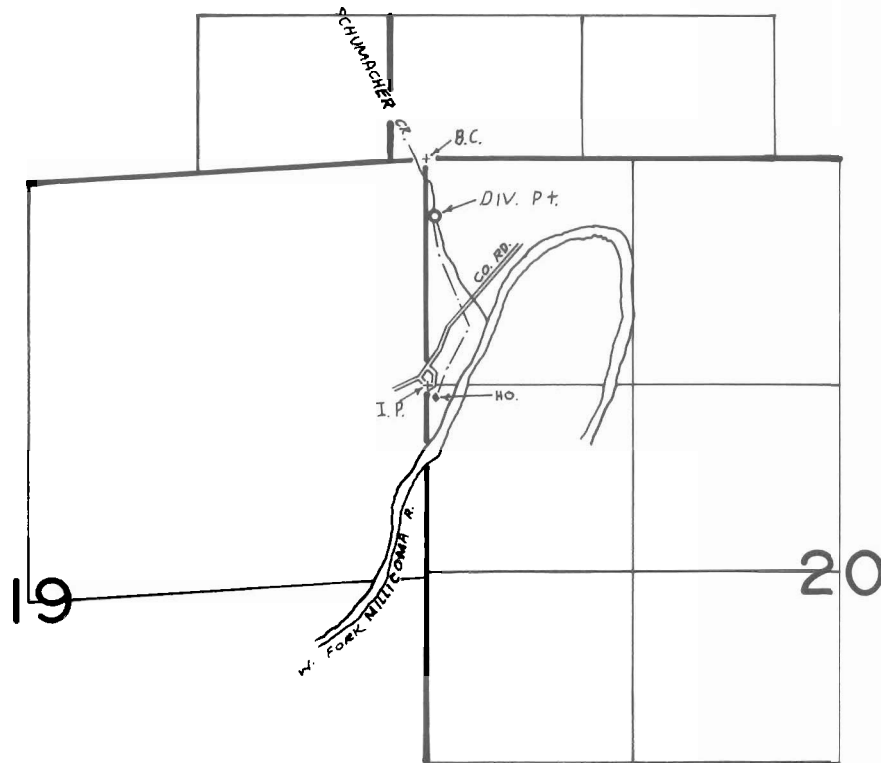

DIV. Pt. LOC. 400'S. 4 50'E. FROM N.W. COR. SEC. 20

## FINAL PROOF SURVEY UNDER

Application No. 49638..... Permit No. 37174.....  
IN NAME OF

.....EARL FRED HUPPI.....

Surveyed JUL. 29, 1977., by D.M. NORBY.....