


T. 26 S., R. 12 W., W.M.

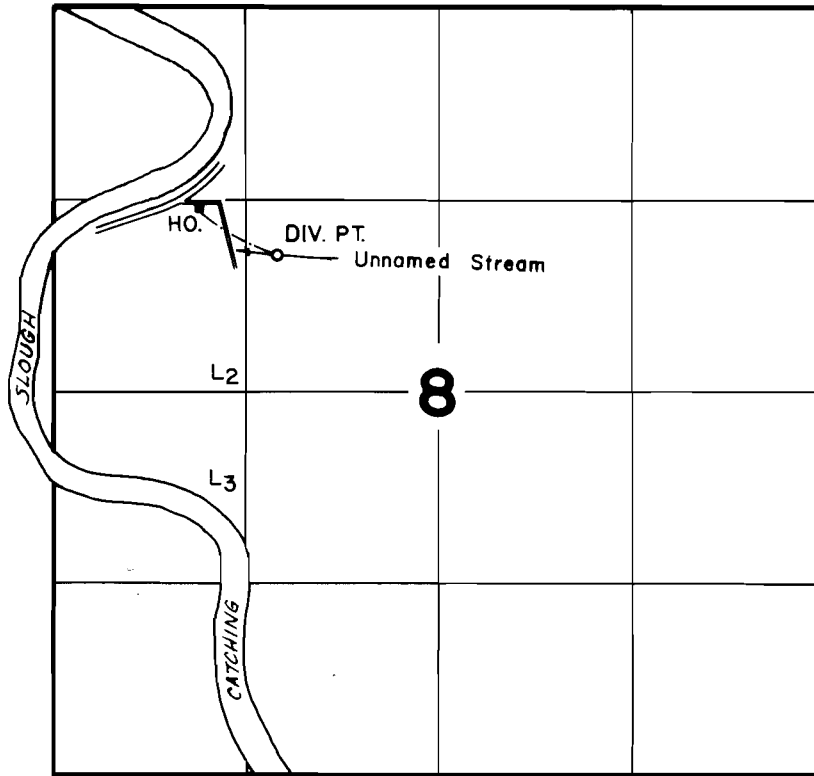

DIV. PT. LOC.: 1720' S. & 1530' E. FROM NW COR. SEC. 8

FINAL PROOF SURVEY
UNDER

Application No. 53432 Permit No. 39759
IN NAME OF

John H. Noah

Surveyed July 27, 1977, by D. Norby

COB-3HH-92 *JCB*