


T.24S.,R.12W.,W.M.

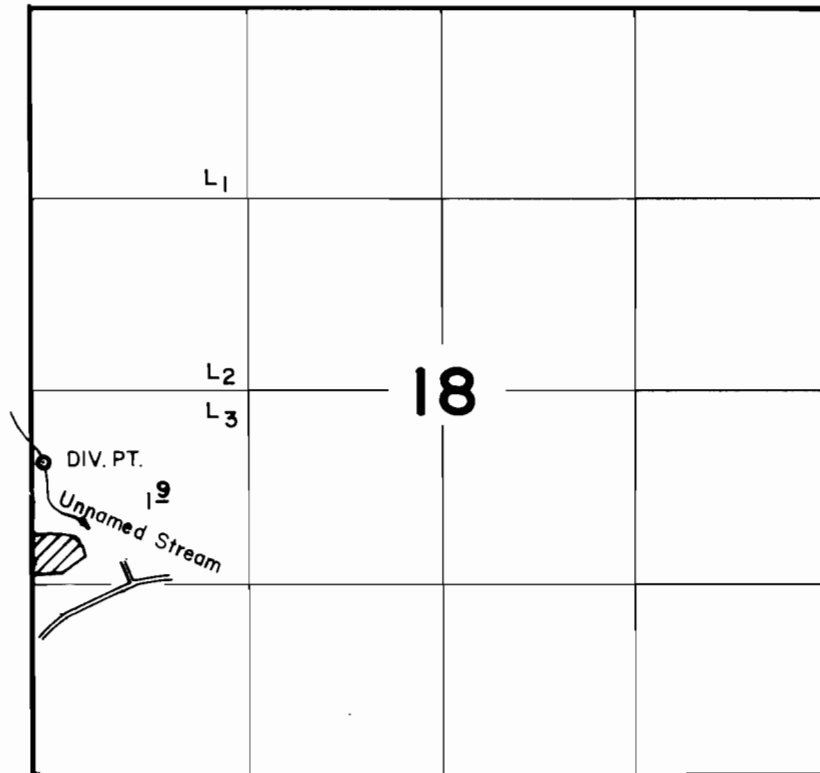

DIV. PT. LOC.: 500' S. & 80' E. FROM W. 1/4 COR. SEC. 18

FINAL PROOF SURVEY
UNDER

Application No. 54575 Permit No. 40954
IN NAME OF

TONY LUCIEN SIMS

Surveyed JULY 28, 1977, by D. NORBY