


T.15S. R.10E. W.M.

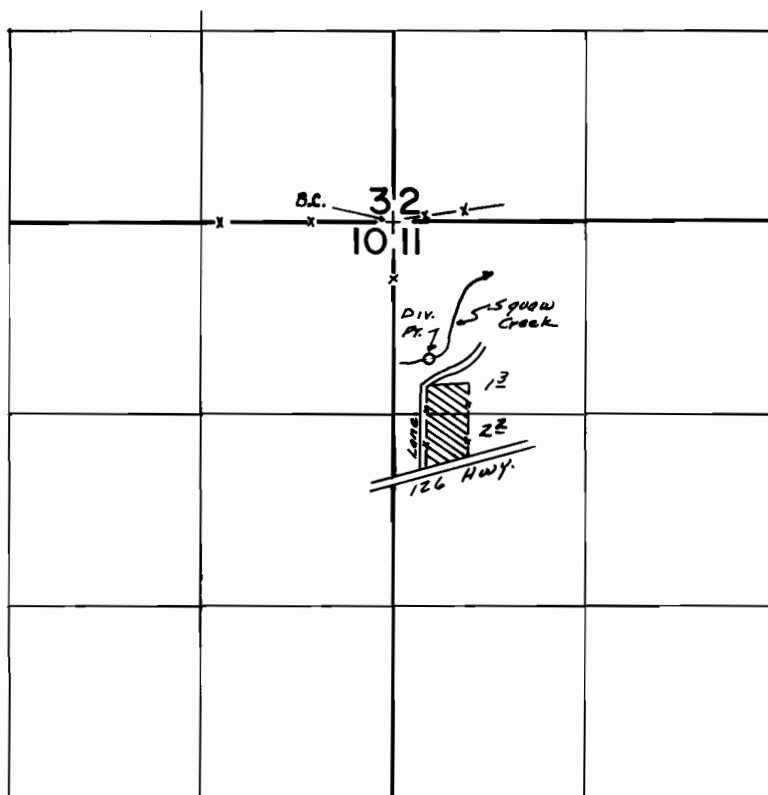

Div. Pt. - 940' S & 240' E From NW Cor. Sec. 11

FINAL PROOF SURVEY UNDER

Application No. 5327.5... Permit No. 39534...
IN NAME OF

.....IRA JACK TROWBRIDGE.....

Surveyed Nov. 4, 1977, by S.C. BROWN.....