


T. 32 S., R. 5 W., W.M.

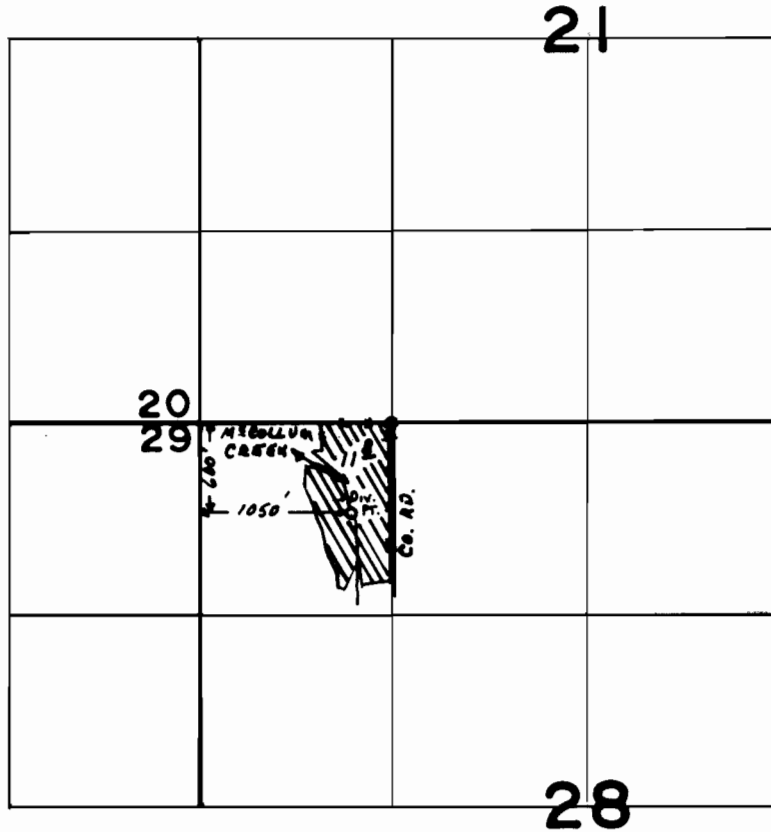

FINAL PROOF SURVEY
UNDER

Application No. 49348... Permit No. 36994.
IN NAME OF

..... **GERALD S. GREGORY**

Surveyed APR. 29 1977, by D.M. NORBY.....