


T.31S.R.18&2W.W.M.

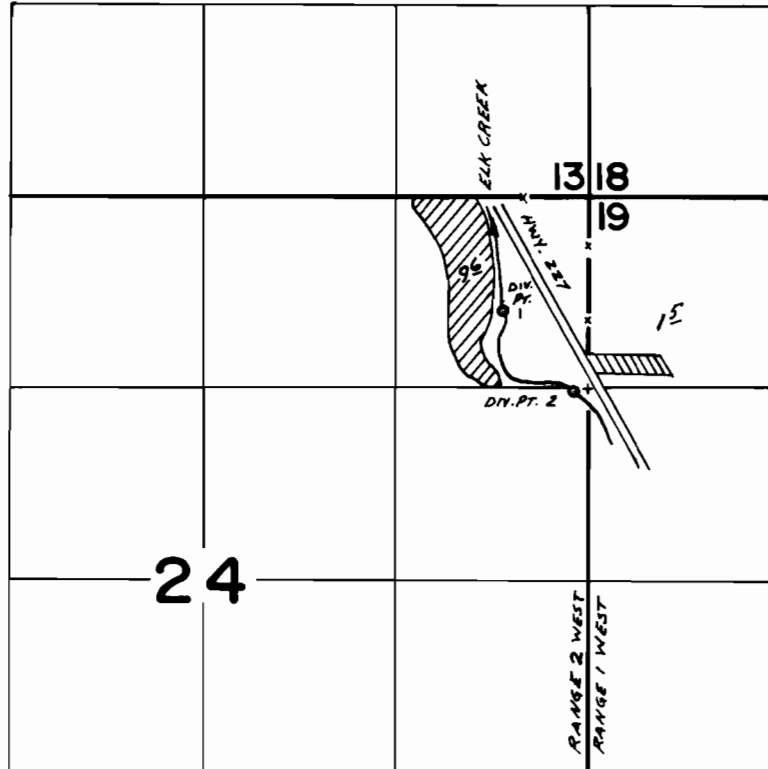

DIV. PT. LOC. $\left. \begin{array}{l} \#1-580'N; 590'W \\ \#2-35'5; 100'W \end{array} \right\}$ BOTH FROM SE COR. NE $\frac{1}{4}$ NE $\frac{1}{4}$ SEC. 24



APP. # 46009



APP. # 50224

FINAL PROOF SURVEY UNDER

Application No. 50224 37705
46009 Permit No. 34363...
IN NAME OF

IVAN L. WILSON

Surveyed MAY 12 1977, by D. NORBY