


T. 30 S., R. 4 W., W.M.

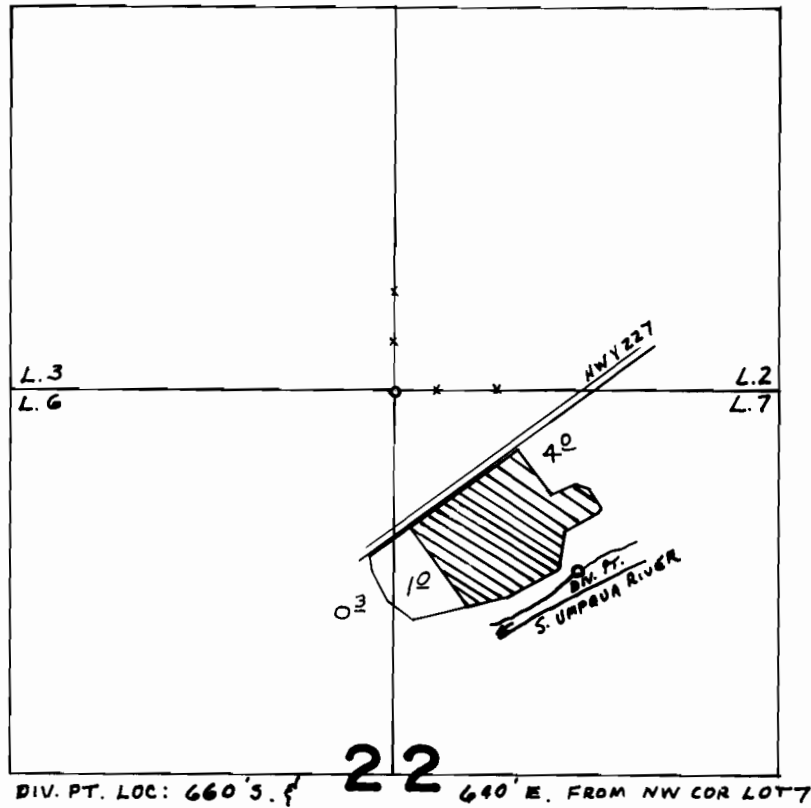

SCALE: 1" = 660'

FINAL PROOF SURVEY UNDER

Application No. 50775 Permit No. 38345
IN NAME OF

JIM. & MARJORIE STEVENS

Surveyed MAY 19 1977, by D. M. NORBY