


T. 33 S., R. 7 W., W.M.

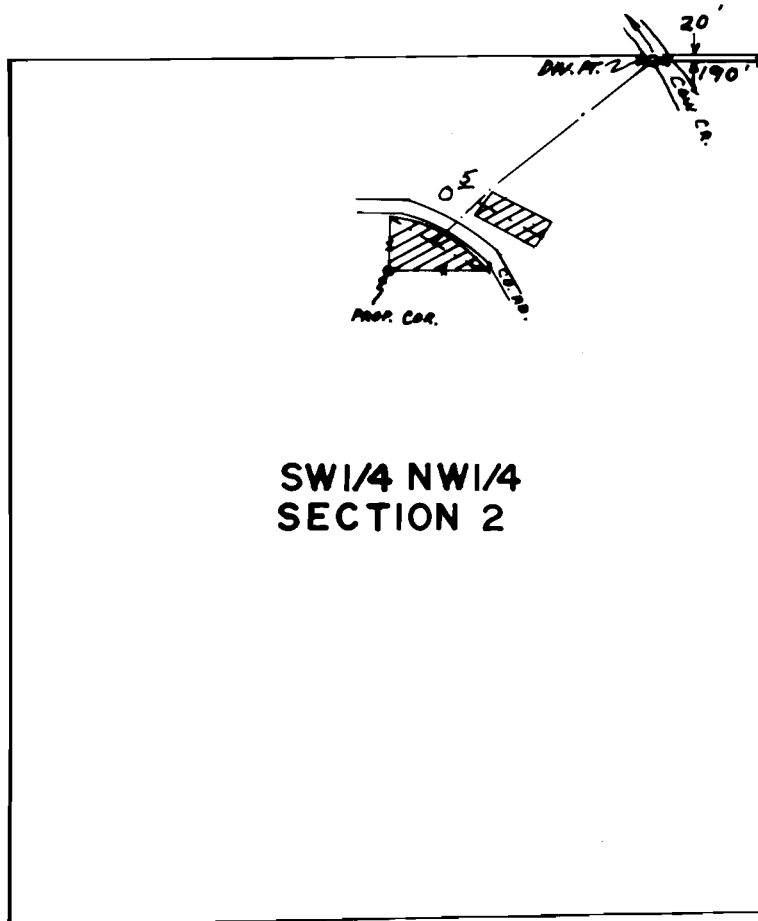

SW 1/4 NW 1/4  
SECTION 2

SCALE: 1" = 330'

**FINAL PROOF SURVEY**  
UNDER

Application No. 534.7.2... Permit No. 39.781....  
IN NAME OF

.....**ROBERT BURROWS**.....

Surveyed May 27, 1977, by D.M. Norby.....