


T. 30 S., R. 4 W., W.M.

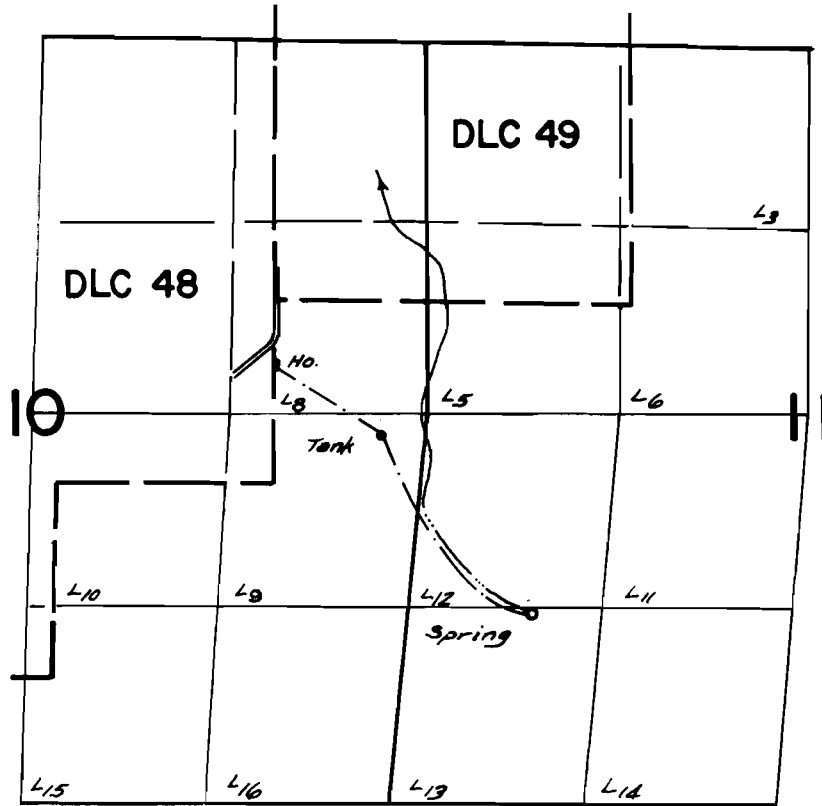

Spring LOC.: 1370 # S. & 700 # E from W $\frac{1}{4}$ Cor. Sec. 11

FINAL PROOF SURVEY
UNDER

Application No. 54327 Permit No. 40673
IN NAME OF

Ted D. Nixon

Surveyed May 13, 1977, by D.M. Norby