


P-40175
47602

T. 1 N. R. 20 E. W. M.

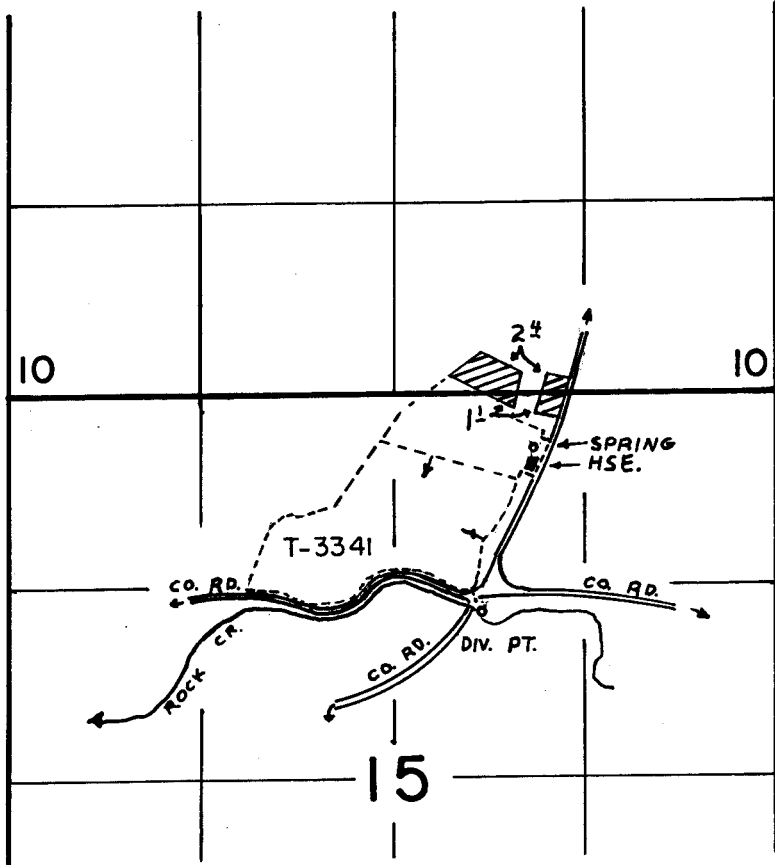

SPRING Loc. 380' S. & 1670' W. FROM S.E. COR. SEC. 10
DIV. Pt. Loc. 1510' S. & 2030' W. FROM N.E. COR. SEC. 15

FINAL PROOF SURVEY UNDER

T-3341
Application No. 53819..... Permit No. 40175.....
IN NAME OF
RONALD W. & GLORIA H. DAVIS
Surveyed OCT. 25, 1977, by R.G. MUCKEN.....