


T-3341  
SPOR V. 28766

# T. 1 N. R. 20 E. W. M.

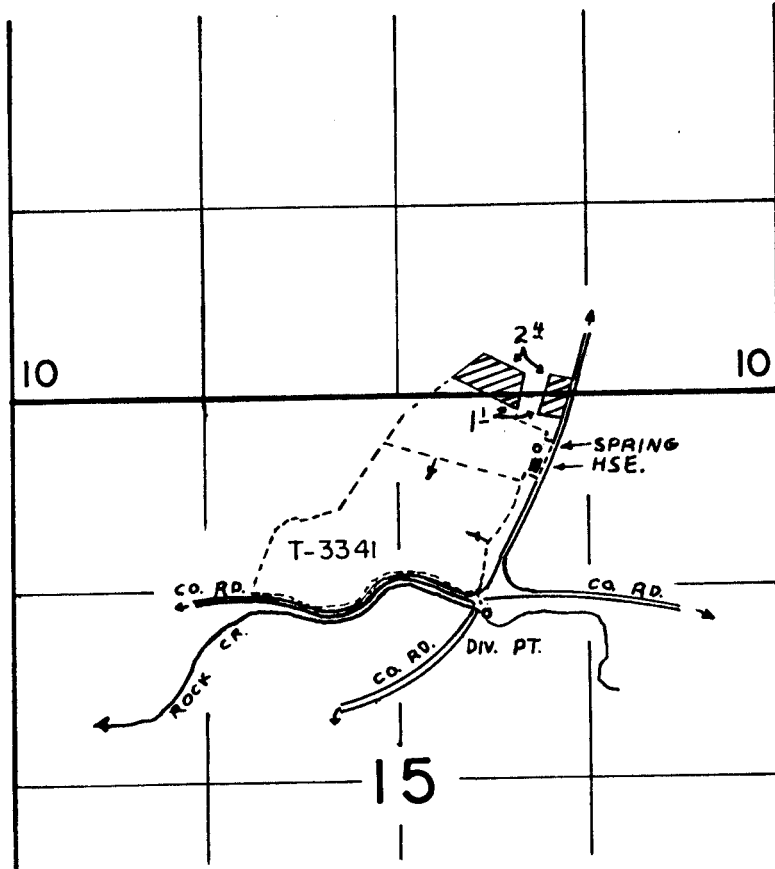

SPRING Loc. 380' S. & 1670' W. FROM S.E. COR. SEC. 10  
DIV. Pt. Loc. 1510' S. & 2030' W. FROM N.E. COR. SEC. 15

## FINAL PROOF SURVEY UNDER

T-3341

Application No. 53819 Permit No. 40175

IN NAME OF

RONALD W. & GLORIA H. DAVIS

Surveyed OCT. 25, 1977, by R.G. MUCKEN