


RECEIVED

MAR 12 1974 G-5227
STATE ENGINEER 47604
SALEM, OREGON

T. 23 S. R. 33 & 34 E. W. M.

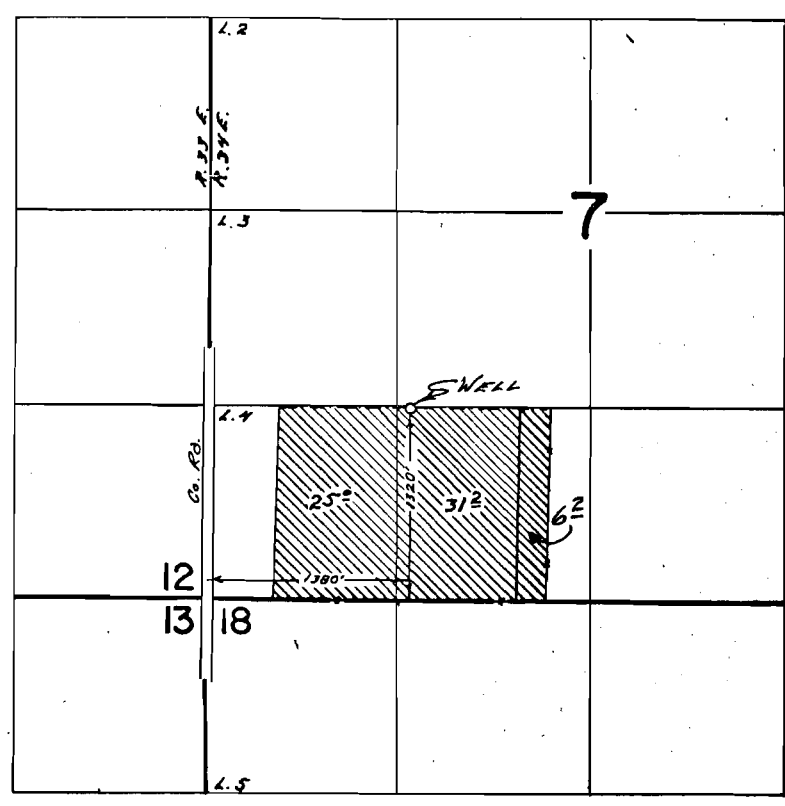

Application No. G-6462
Permit No. G-5227

FINAL PROOF SURVEY
UNDER

Application No. G-4972 Permit No. G-4689
IN NAME OF

LYLE E. & HELEN VICKERS

Surveyed Aug. 24 1972, by R. G. MUCKEN

1972 M RJP