


T. 33 S., R. 1 E., W. M.

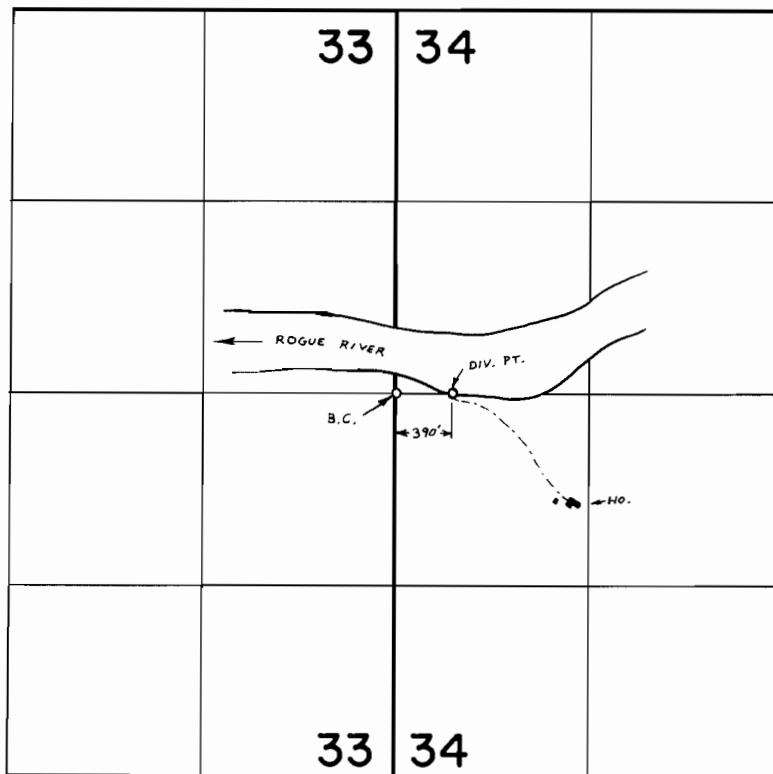

FINAL PROOF SURVEY
UNDER

Application No. 54055 Permit No. 40428
IN NAME OF

TRUMAN DEAN & Z. IDELLE COLLINS

Surveyed AUG. 16, 1978, by B. SUND