


VICINITY MAP
SCALE: 1" = 2 MILES

OREGON
CALIFORNIA




SEC. 25, T. 40 S., R. 15 E., W. M.

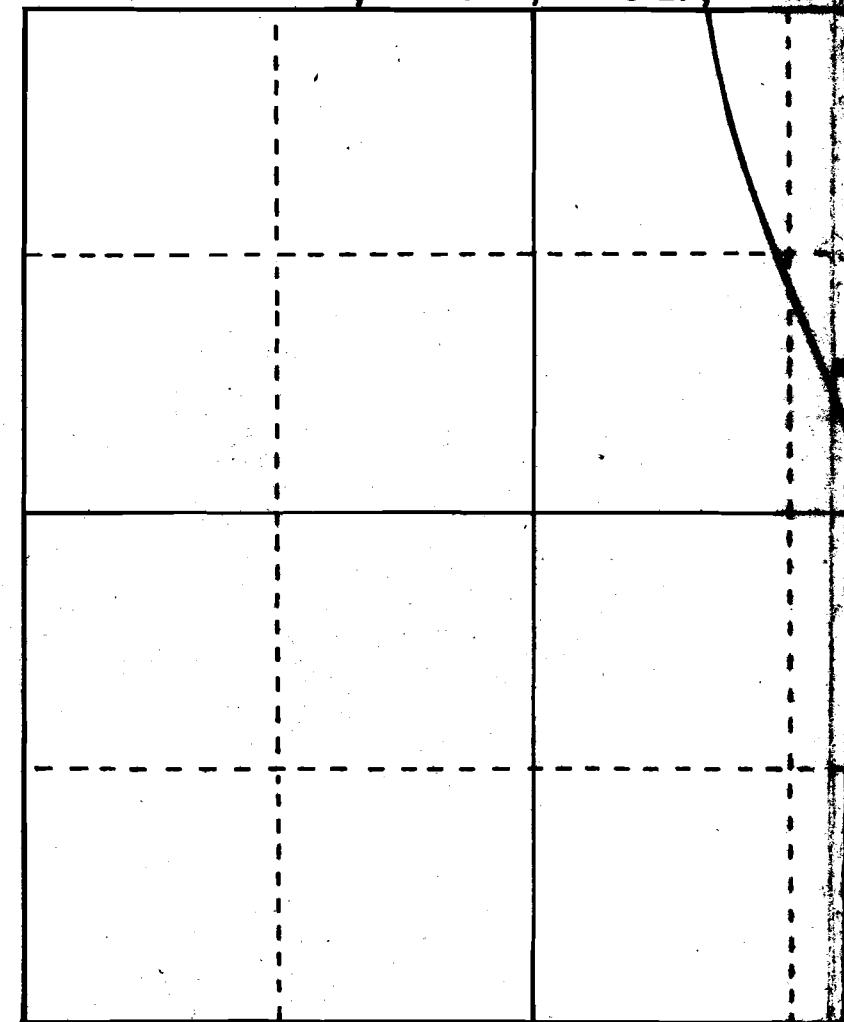

SCALE: 1" = 1000'

I, A.L. MOORE OF WEYERHAEUSER COMPANY DO HEREBY CERTIFY
THAT THIS MAP WAS MADE FROM NOTES TAKEN DURING AN
ACTUAL SURVEY MADE UNDER MY IMMEDIATE SUPERVISION
ON FEB. 17, 1966; THAT THE MONUMENT SHOWN ON THIS MAP
IS A BRASS CAP. THE WELL SHOWN BEARS N 57° 10' W, DISTANT
1,060.31 FT. FROM THE EAST 1/4 CORNER OF SECTION 25,
TOWNSHIP 40 SOUTH, RANGE 15 EAST, WILLAMETTE MERIDIAN.

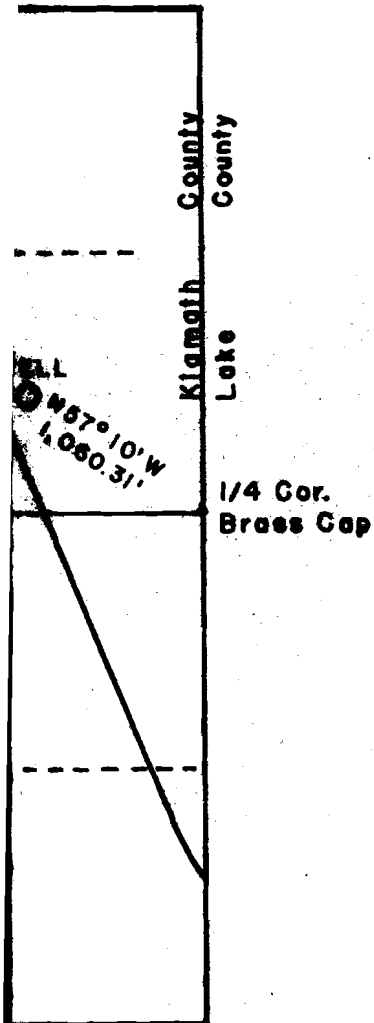

A.L. Moore
NOV. 10, 1944
A. L. MOORE
47

Application No. *G-3455*
Permit No. *G-3261*

CAMP 16 TRUCK ROAD WELL
LOCATION



Weyerhaeuser Company
Klamath Falls Branch

SCALE - AS SHOWN

DATE - MAR. 14, 1966

DEL. - C.L.C.

CHECKED BY -

TRACED - C.L.C.

DRAWING No - K 276