


# T.38S. R.11 1/2 E. W.M.

Buck Creek: Jonna Valley wells

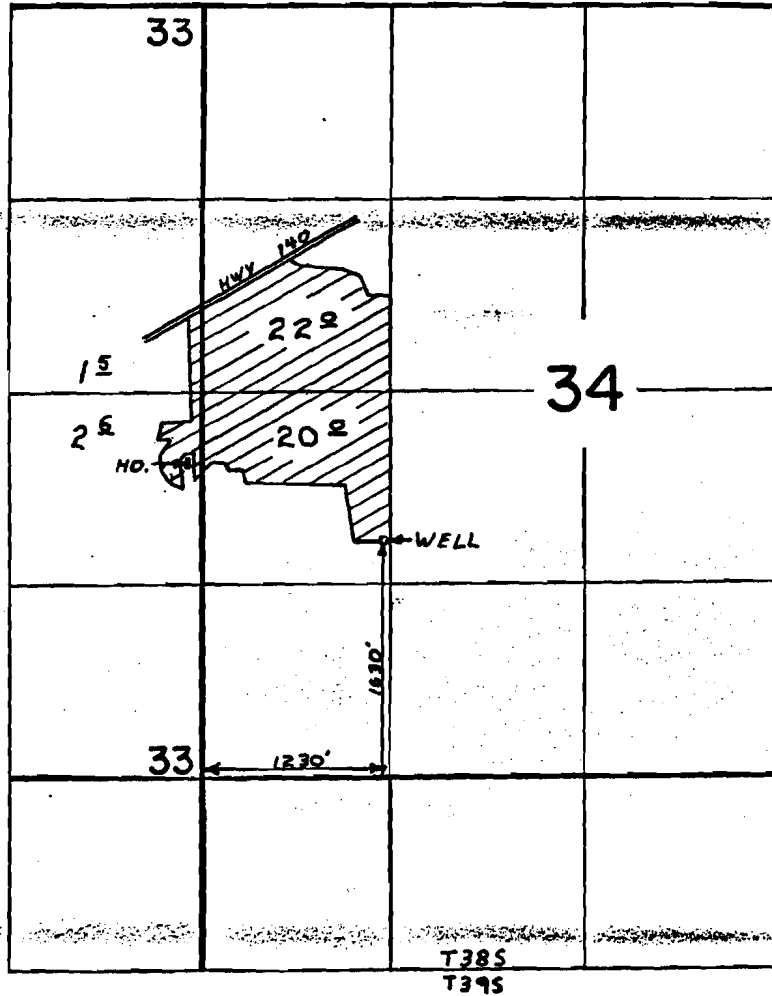

## FINAL PROOF SURVEY UNDER

Application No. G-5182... Permit No. G-5054..  
IN NAME OF

ERNEST E. & GRACE L. WISEMAN

Surveyed OCT. 19, 1977, by R.G. MUCKEN...