


G-5230

T.37&38S.R11 1/2 E.W.M. 47609

Application No. G-5344

Permit No. G-5230

Buck Creek; Gamma Valley
wells

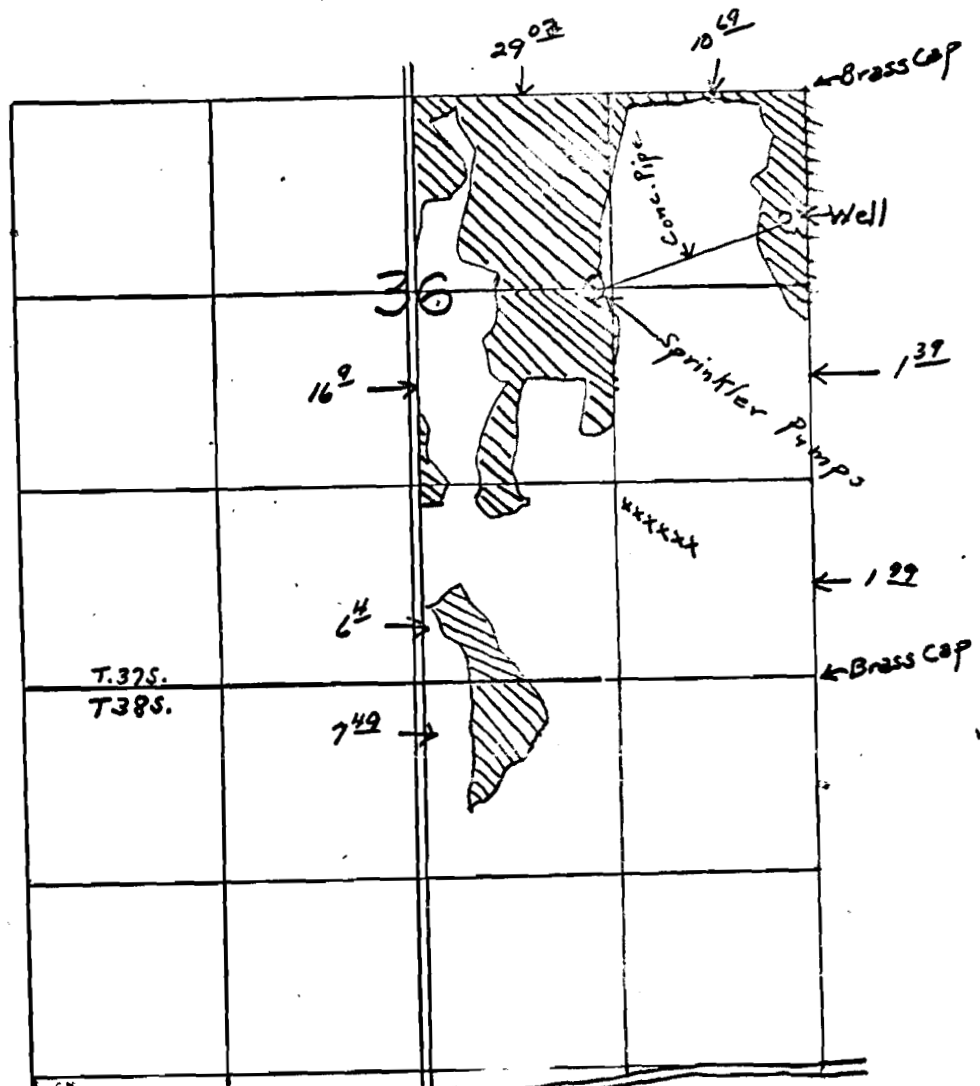

Application No. G-5344

Permit No. G-5230

Total acres To be added → 73.93

DONALD E. & VIRGINIA H. SCHREINER